


Section 10, T6N, R10E, Town of Dunn, Dane County, Wisconsin.

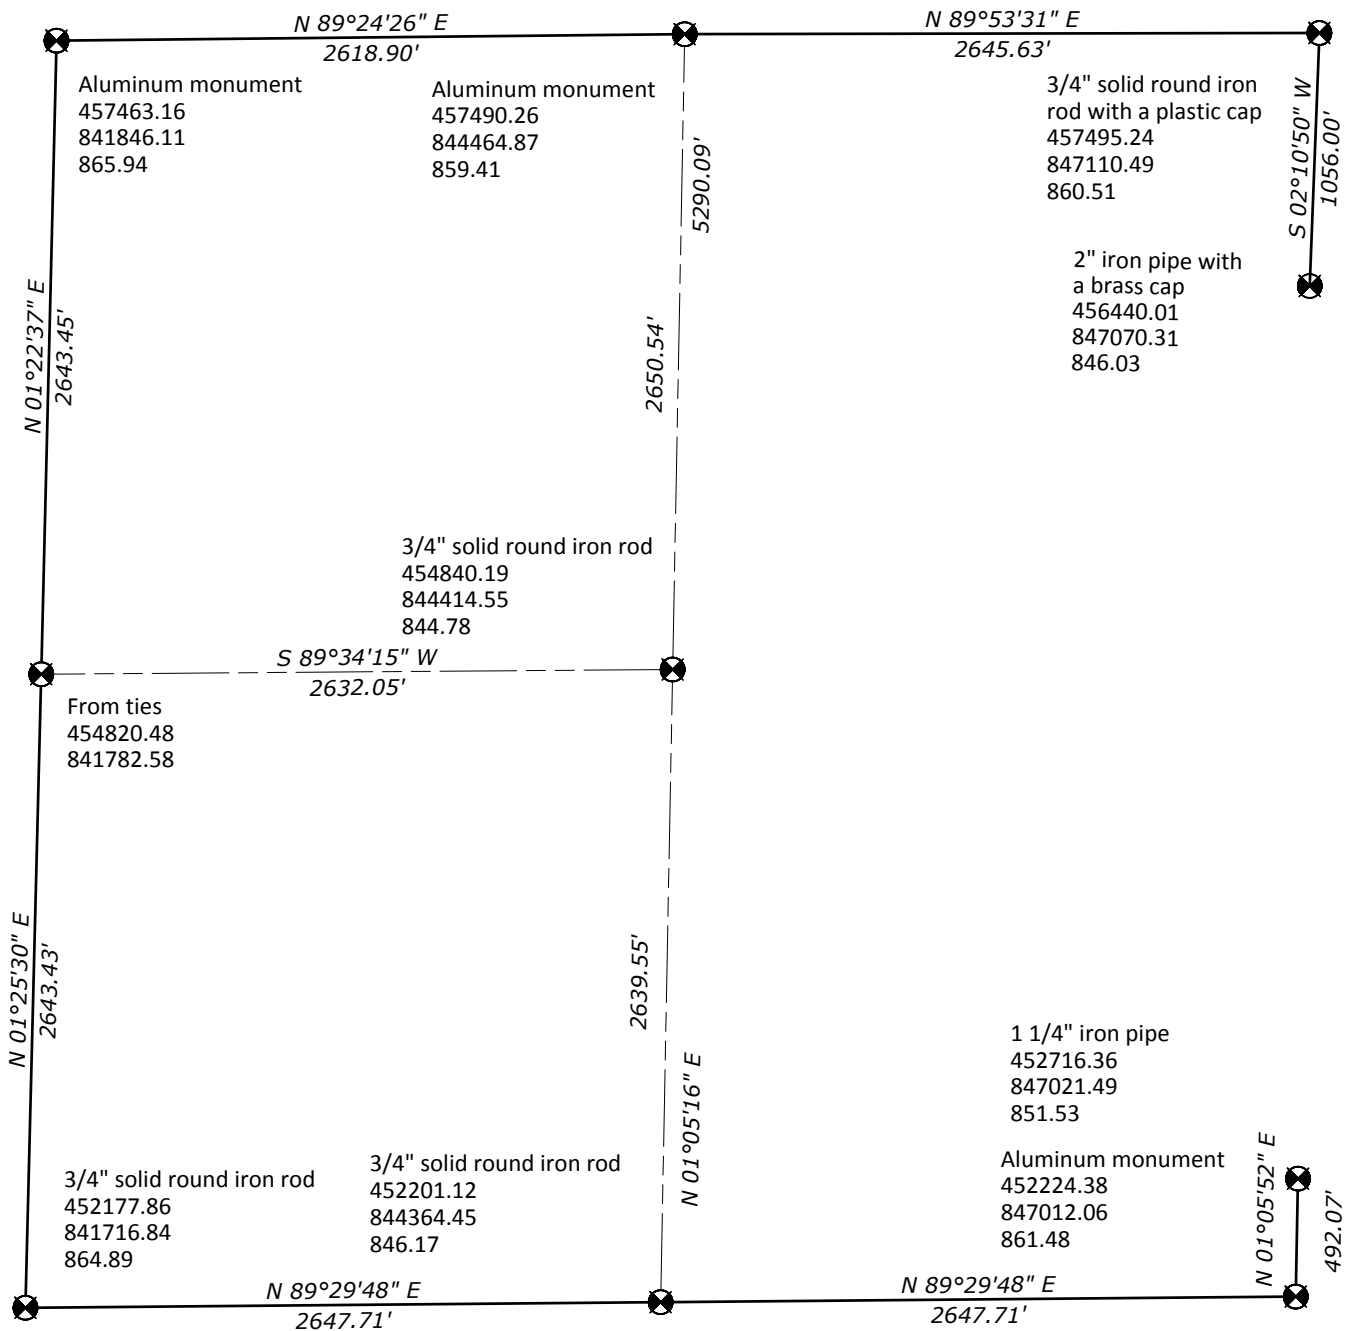

WISCONSIN

RICHARD W.
MARKS
S-1473
SAUK CITY,
WIS.

LAND SURVEYOR

