



SECTION SUMMARY SHEET

Section 18, T6N, R10E, Town of Dunn, Dane County, Wisconsin.

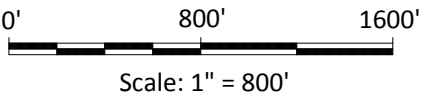

SECTION 24, T6N, R9E

SECTION 13, T6N, R9E

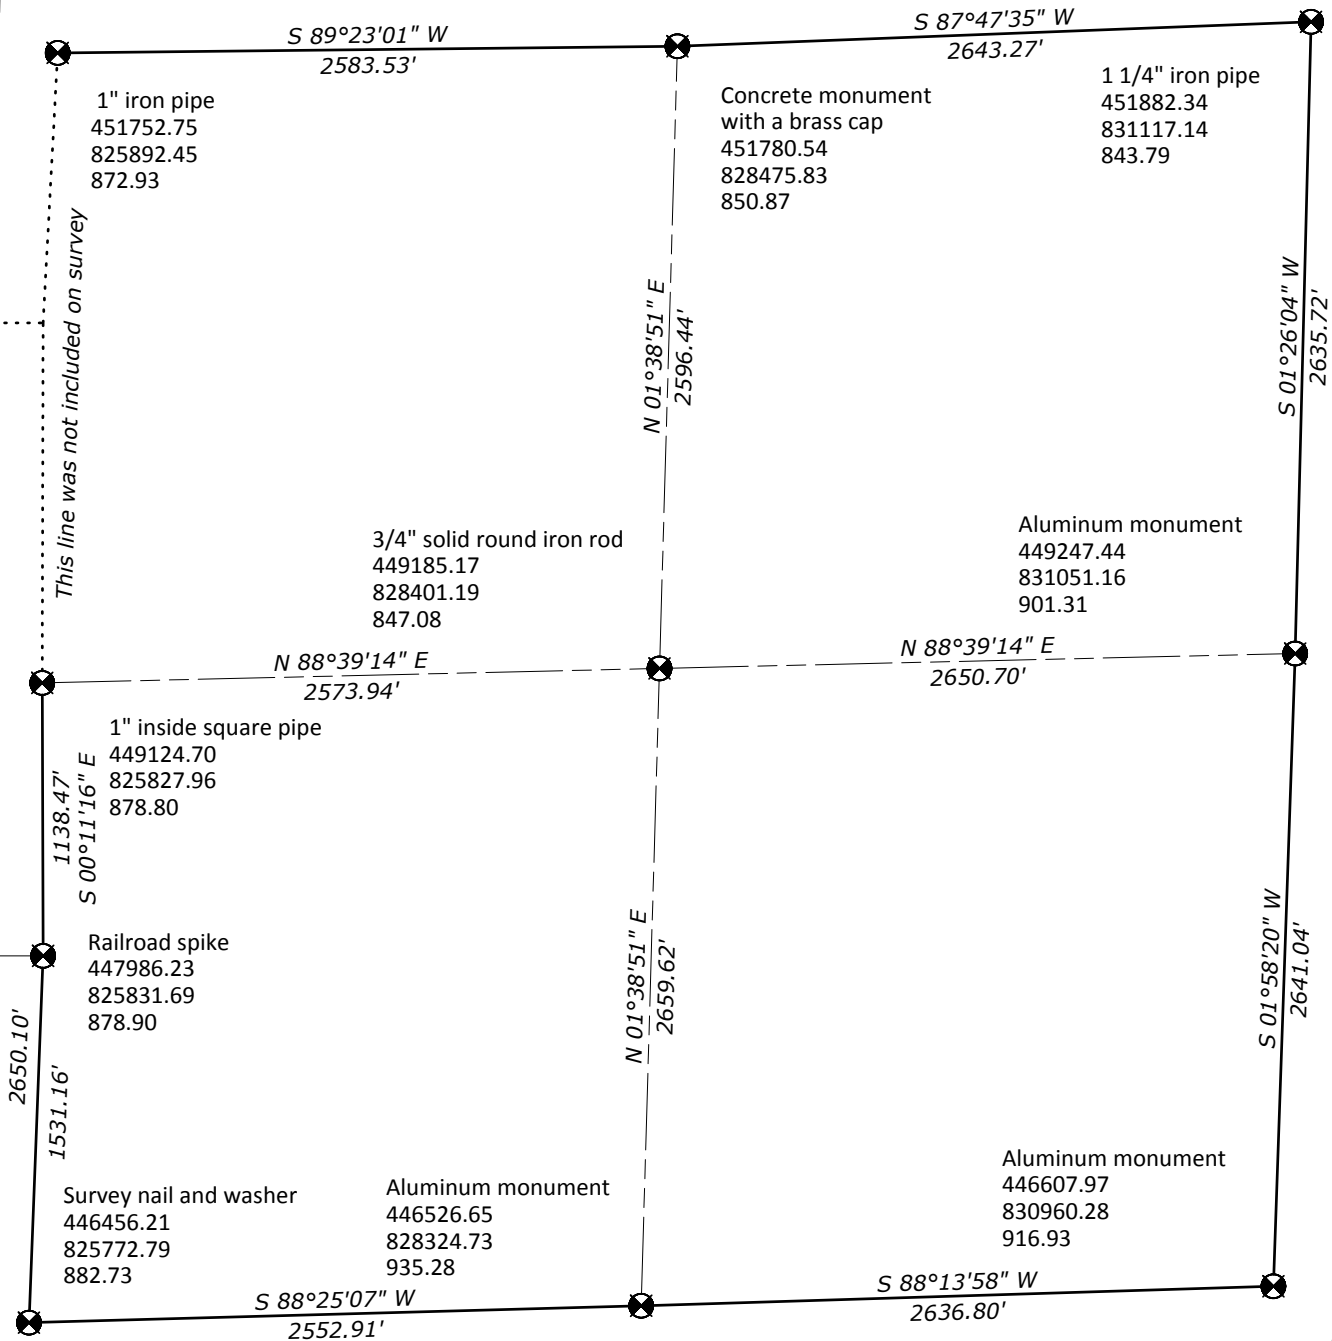

Prepared by:
River Valley Land Surveying
504 Cedar Street
Sauk City, Wisconsin 53583
www.rivervalleylandsurveying.com

I, Richard Marks, Professional Land Surveyor number S-1473 hereby certify that the Section summary shown on this record was determined by me or under my direction and is correct. This Summary Sheet is complete to the best of my knowledge and belief.

Richard Marks 9/28/2014

Richard Marks Date
Professional Land Surveyor number S-1473

