



R.F. Sarko and Associates, Inc.
Land Surveyors
2919 University Avenue
Madison, Wisconsin 53705

R.F. Sarko and Associates, Inc.
Land Surveyors
2919 University Avenue
Madison, Wisconsin 53705

OLD MIDDLETON is RD.

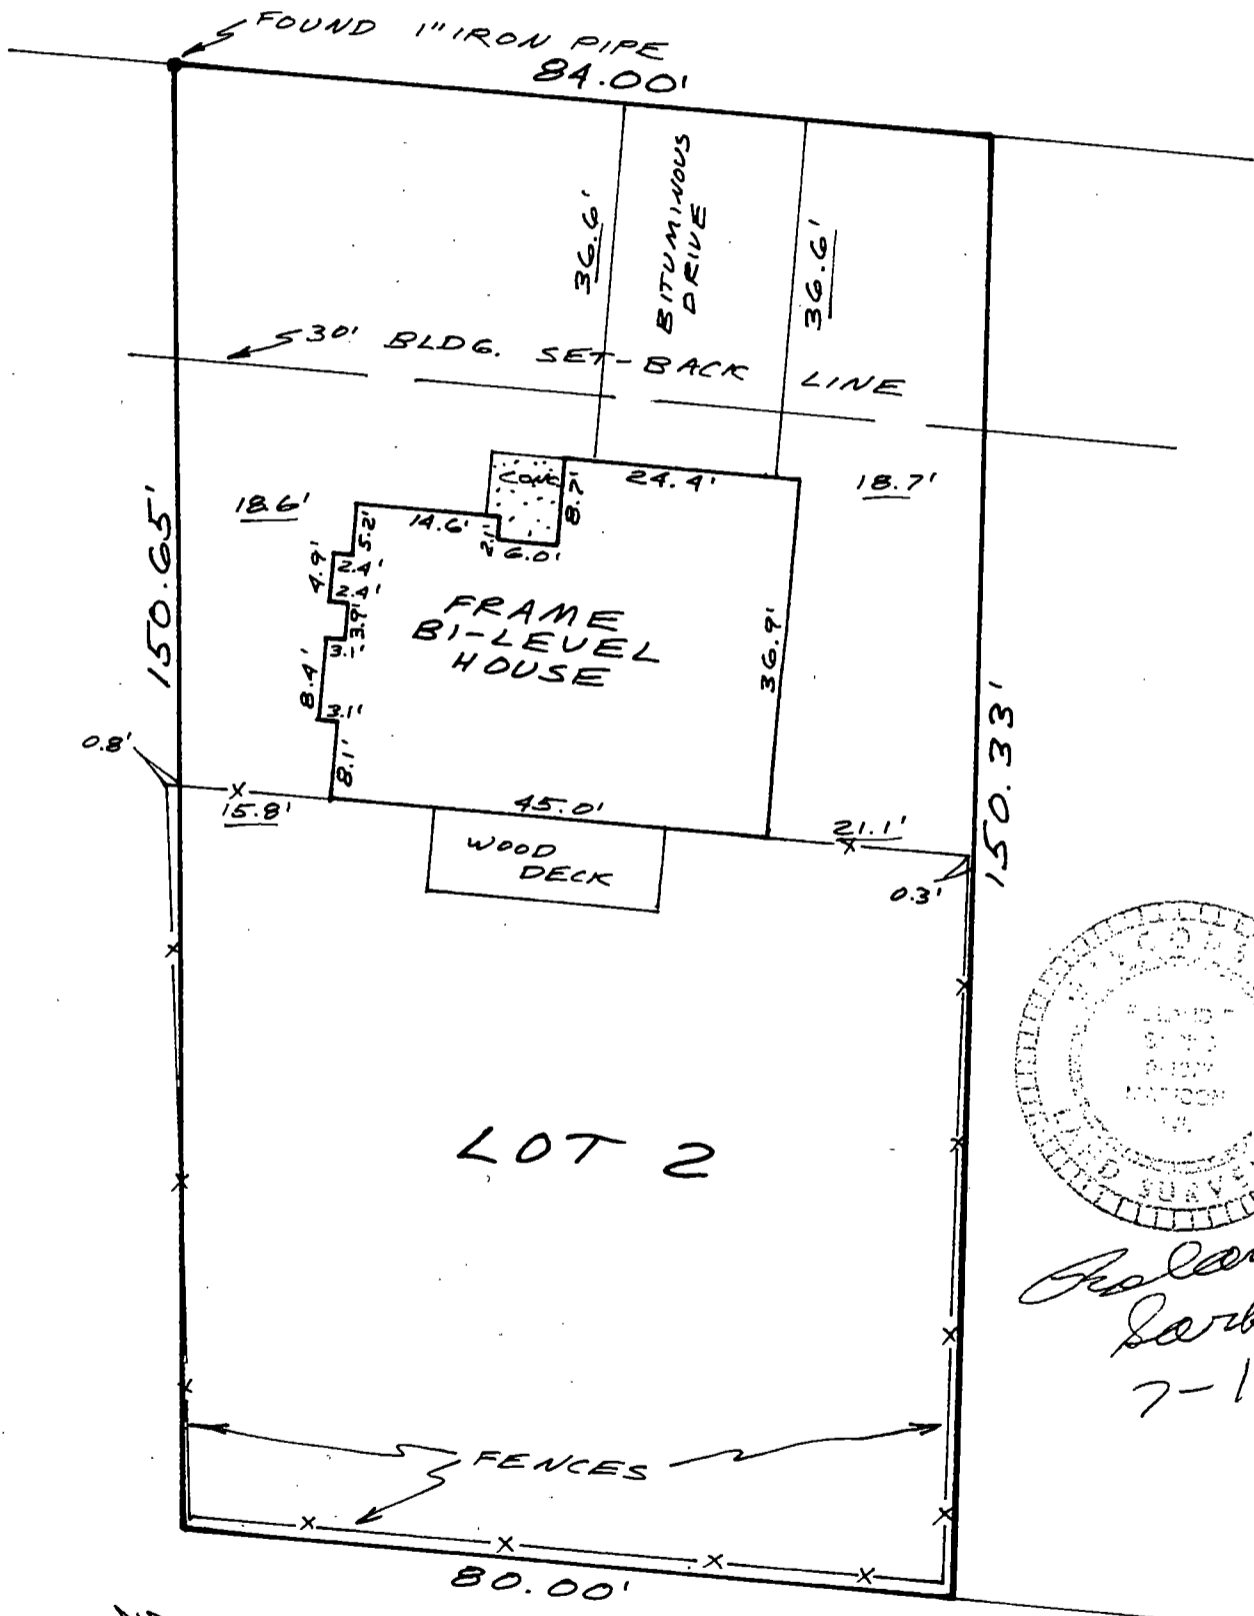

A circular seal of the U.S. Coast Guard, 19th District, Portland, Maine. The outer ring contains the text "U.S. COAST GUARD" at the top and "19th DISTRICT" at the bottom. The inner circle contains the text "PORTLAND, MAINE" at the top and "U.S. COAST GUARD" at the bottom. In the center, there is a small emblem featuring a shield with a cross and a anchor, with the text "1808" below it.


 Ireland
 Sarkis
 7-1-86

Map Number: 4-17100
Job Number: 11525
Page One of Two

MORTGAGE INSPECTION

R.F. Sarko and Associates, Inc.
Land Surveyors
2919 University Avenue
Madison, Wisconsin 53705

LEGAL DESCRIPTION OF PROPERTY INSPECTED:

Lot 2, Certified Survey Map Number 1756, recorded in Volume 7 of Certified Surveys on Pages 144 and 145 as Document Number 1437448, City of Madison, Dane County, Wisconsin.

ADDRESS OF PROPERTY INSPECTED:

6115 Old Middleton Road
Madison, Wisconsin

INSPECTED FOR:

Anchor Savings and Loan Association
25 West Main Street
Madison, Wisconsin 53703

ATTN:

John Johnson


CLIENT:


Regis W. Lecoanet and Robin Moskowitz-Lecoanet

CERTIFICATE:

"I, Roland F. Sarko, Registered Land Surveyor in the State of Wisconsin, do hereby certify that I have inspected the above described property and that I have mapped the property according to the official records and that I have mapped the locations of all visible structures, the dimensions of all principal buildings, roadways, apparent easements and visible encroachments, if any. This mortgage inspection has been prepared in accordance with the requirements of the Anchor Savings and Loan Association and under an agreement between R.F. Sarko and Associates, Inc. and the Anchor Savings and Loan Association which excludes this mortgage inspection from all of the requirements of Section AE 5.01, Wisconsin Administrative Code. Therefore, all of the requirements of Section AE 5.01 have not been complied with. This mortgage inspection is made for the exclusive use of the present owners of the property and also those who purchase, mortgage or guarantee the title thereto within one year from date hereof and as to them we certify the accuracy of said mortgage inspection as shown."

Dated this 1st day of July, 1986.


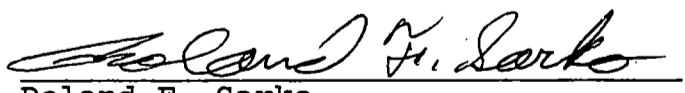

Roland F. Sarko
Wisconsin Registered Land Surveyor
Number S-1377

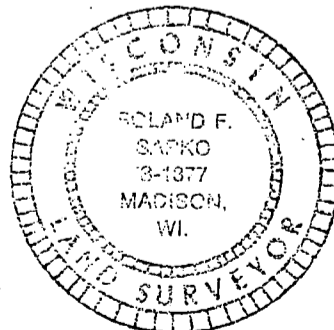

Map Number: 4-17100
Job Number: 11525
Page Two of Two

MORTGAGE INSPECTION

R.F. Sarko and Associates, Inc.
Land Surveyors
2919 University Avenue
Madison, Wisconsin 53705

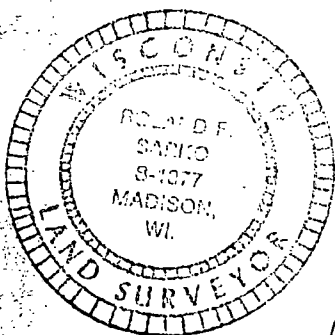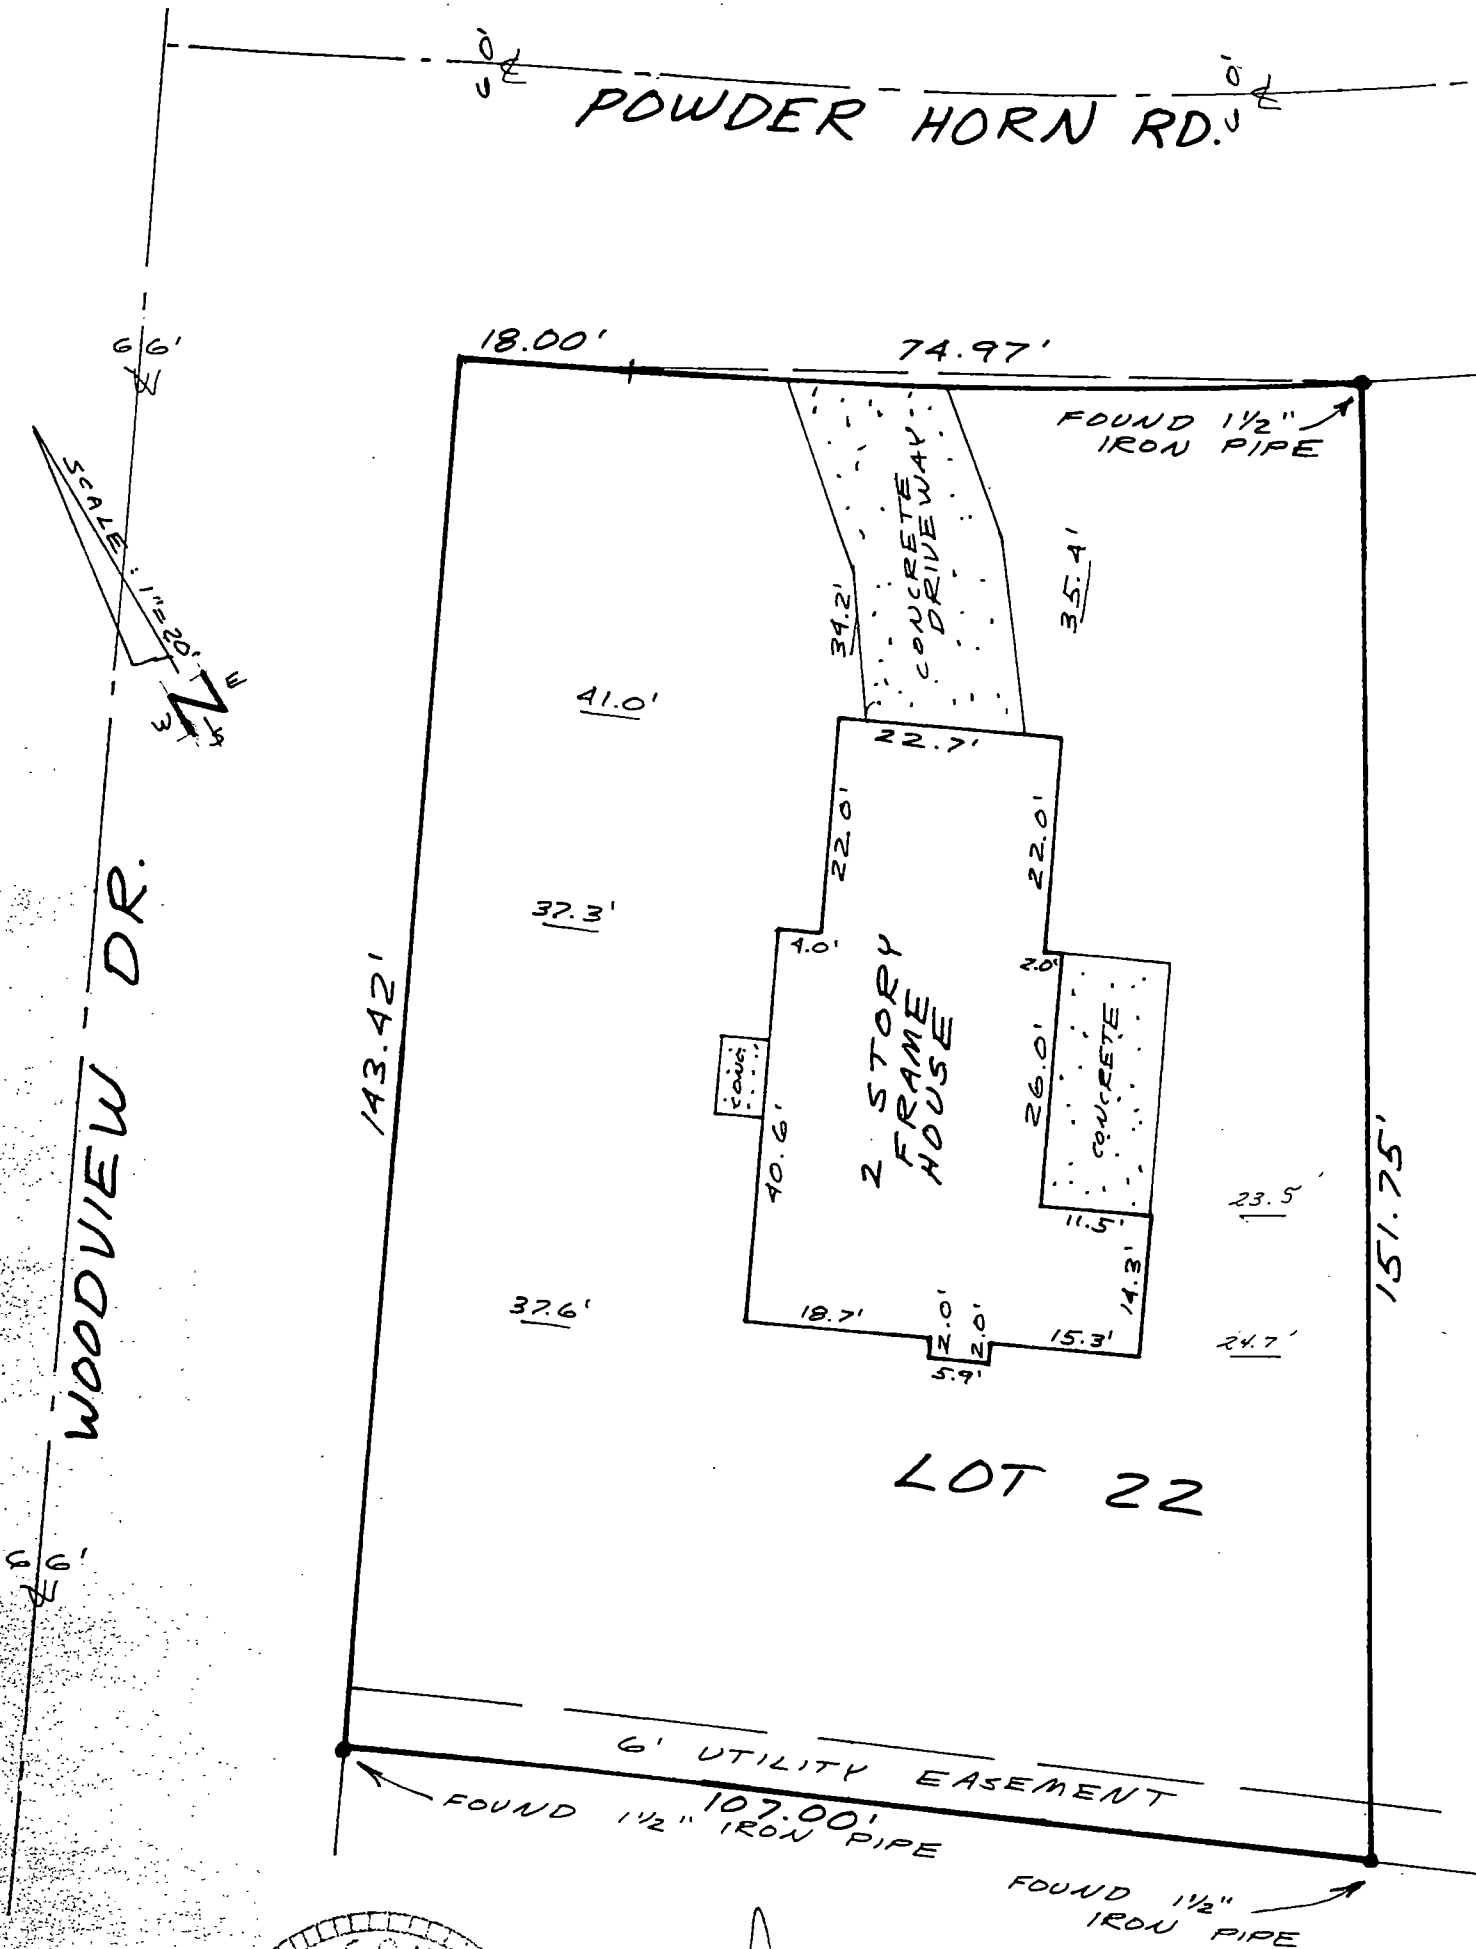

R.F. Sarko
7-1-86

Map Number: 4-17101
Job Number: 12382
Page One of Two

MORTGAGE INSPECTION

R.F. Sarko and Associates, Inc.
Land Surveyors
2919 University Avenue
Madison, Wisconsin 53705

LEGAL DESCRIPTION OF PROPERTY INSPECTED:

Lot 22, Carriage Hill, City of Sun Prairie, Dane County,
Wisconsin.

ADDRESS OF PROPERTY INSPECTED:

813 Woodview Drive
Sun Prairie, Wisconsin

INSPECTED FOR:

First American Title Insurance Company of Mid-America
1717 West Beltline Highway
Madison, Wisconsin 53713


CLIENT:


Dennis and Judith Schoeberle
MA-860861-IDL

CERTIFICATE:

"I, Roland F. Sarko, Registered Land Surveyor in the State of Wisconsin, do hereby certify that I have inspected the above described property and that I have mapped the property according to the official records and that I have mapped the locations of all visible structures, the dimensions of all principal buildings, roadways, apparent easements and visible encroachments, if any. This mortgage inspection has been prepared in accordance with the requirements of the First American Title Insurance Company of Mid-America and under an agreement between R.F. Sarko and Associates, Inc. and the First American Title Insurance Company of Mid-America which excludes this mortgage inspection from all of the requirements of Section AE 5.01, Wisconsin Administrative Code. Therefore, all of the requirements of Section AE 5.01 have not been complied with. This mortgage inspection is made for the exclusive use of the present owners of the property and also those who purchase, mortgage or guarantee the title thereto within one year from date hereof and as to them we certify the accuracy of said mortgage inspection as shown."

Dated this 1st day of July, 1986.

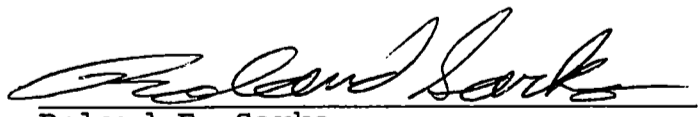

Roland F. Sarko
Wisconsin Registered Land Surveyor
Number S-1377

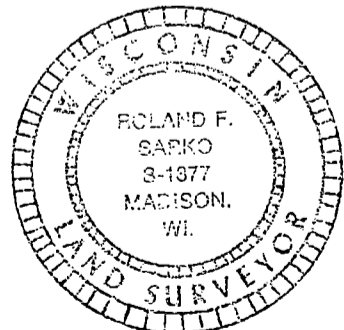

Map Number: 4-17101
Job Number: 12382
Page Two of Two

MORTGAGE INSPECTION

R.F. Sarko and Associates, Inc.
Land Surveyors
2919 University Avenue
Madison, Wisconsin 53705

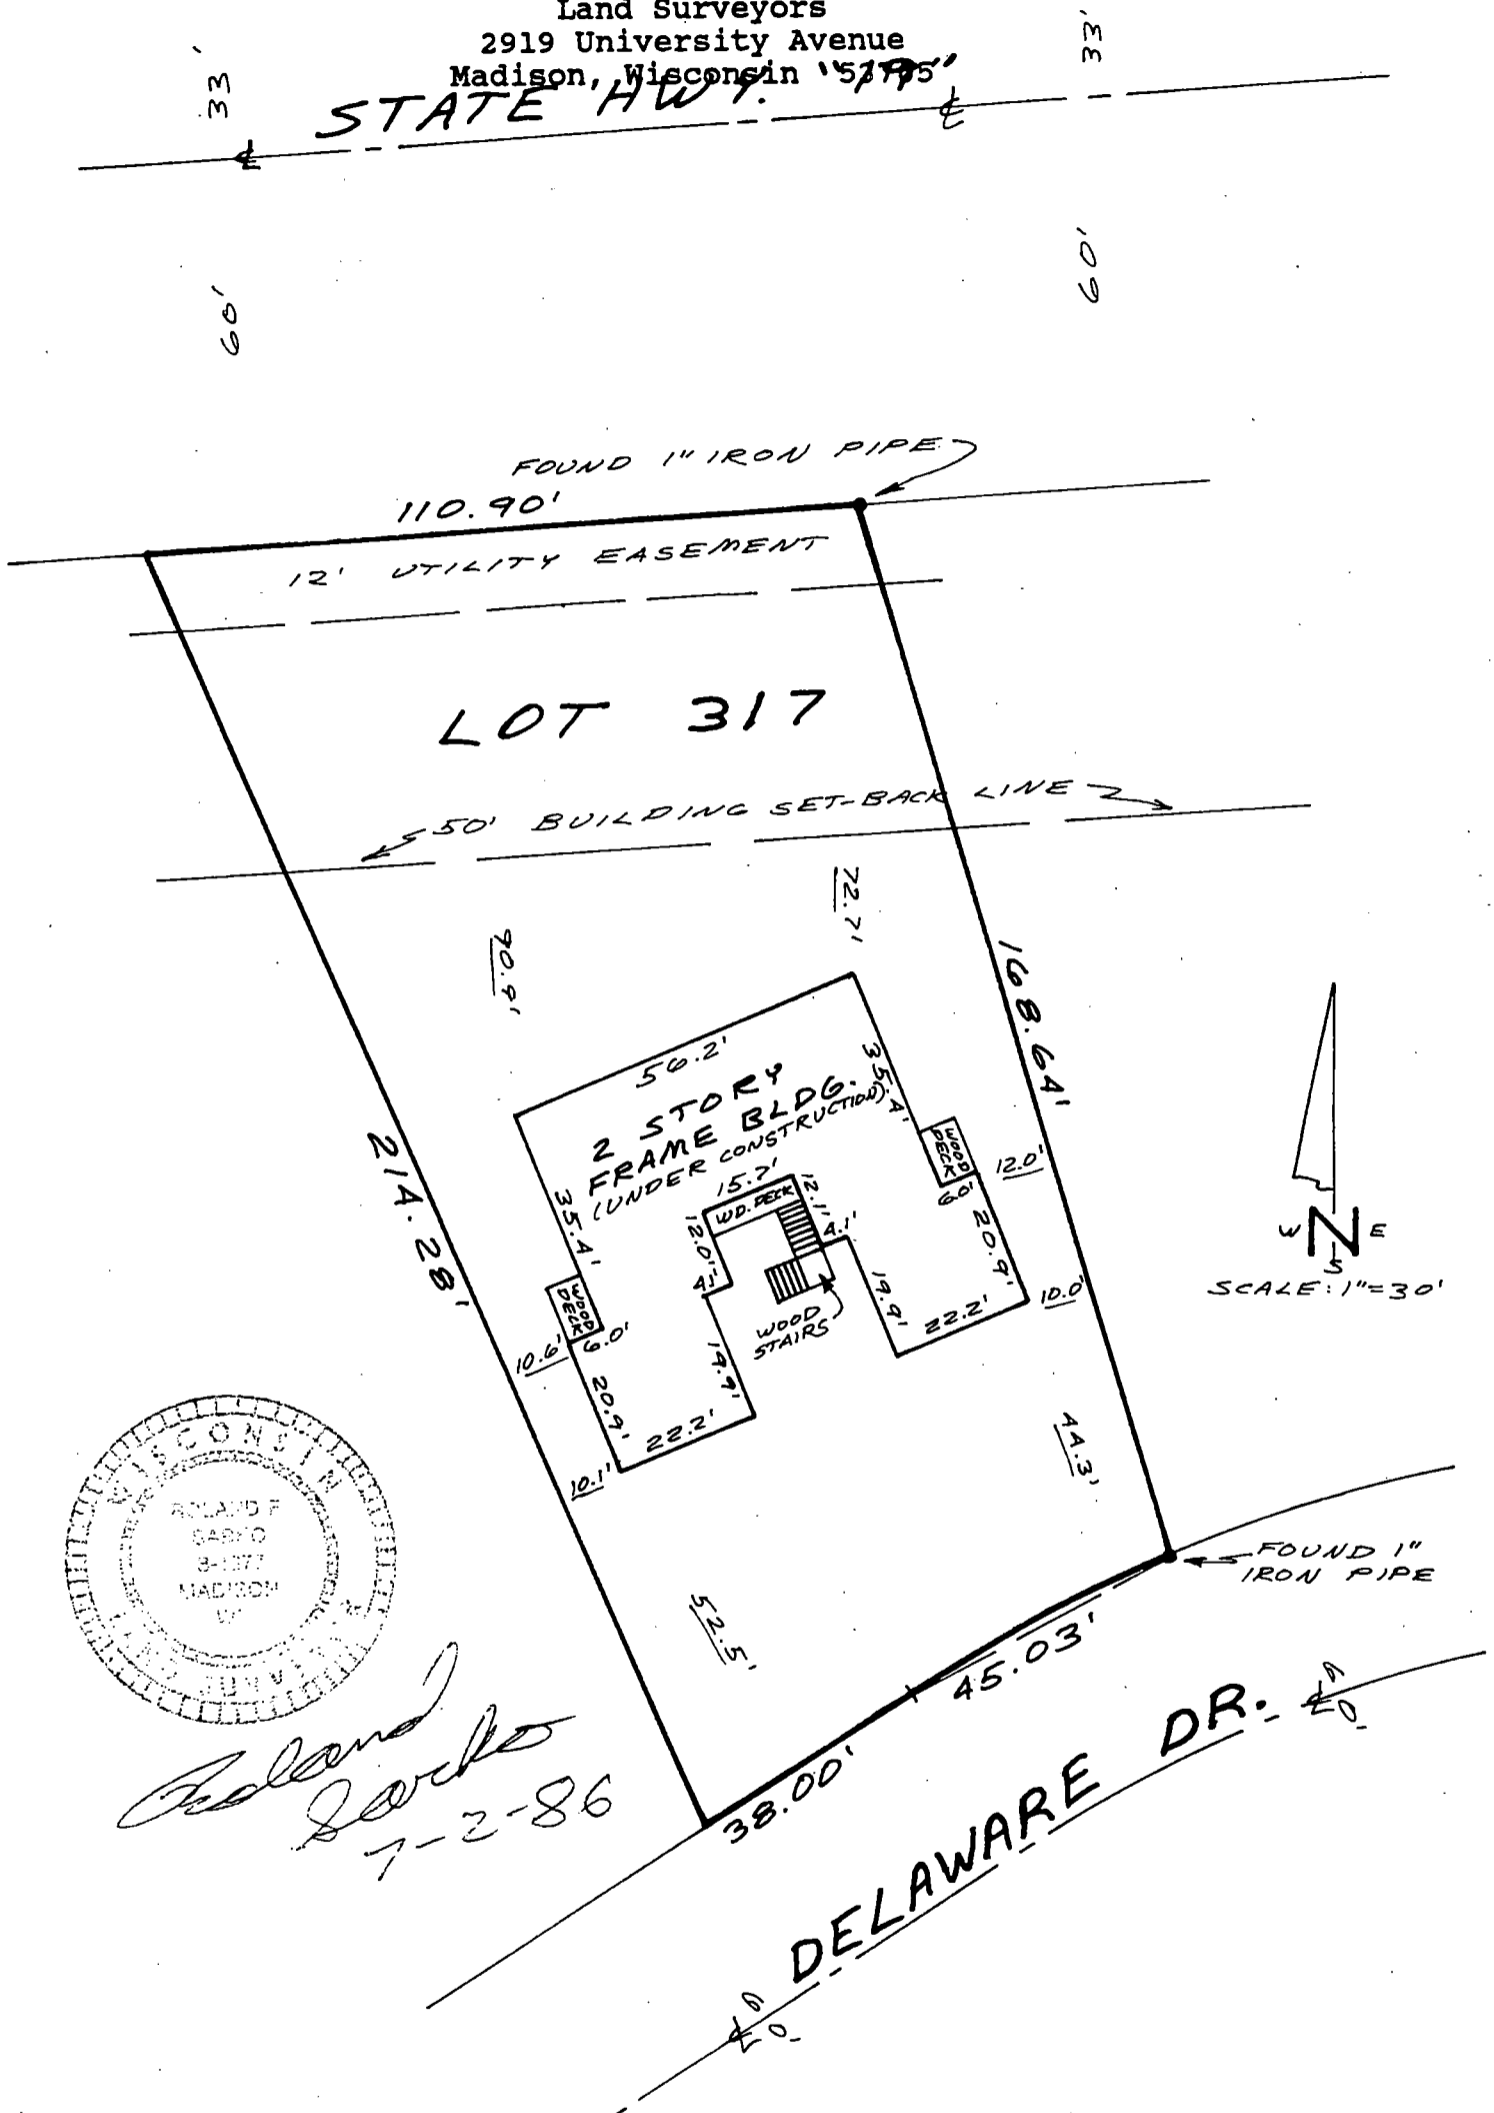

MORTGAGE INSPECTION

R.F. Sarko and Associates, Inc.
Land Surveyors
2919 University Avenue
Madison, Wisconsin 53705

LEGAL DESCRIPTION OF PROPERTY INSPECTED:

Lot 317, Ninth Addition to Royal Oaks, City of Sun Prairie,
Dane County, Wisconsin.

ADDRESS OF PROPERTY INSPECTED:

1800 Delaware Drive
Sun Prairie, Wisconsin

INSPECTED FOR:

Anchor Savings and Loan Association
216 Cottage Grove Road
Madison, Wisconsin 53716

Attn:
Paul


CLIENT:


Larry Schlitz

CERTIFICATE:

"I, Roland F. Sarko, Registered Land Surveyor in the State of Wisconsin, do hereby certify that I have inspected the above described property and that I have mapped the property according to the official records and that I have mapped the locations of all visible structures, the dimensions of all principal buildings, roadways, apparent easements and visible encroachments, if any. This mortgage inspection has been prepared in accordance with the requirements of the Anchor Savings and Loan Association and under an agreement between R.F. Sarko and Associates, Inc. and the Anchor Savings and Loan Association which excludes this mortgage inspection from all of the requirements of Section AE 5.01, Wisconsin Administrative Code. Therefore, all of the requirements of Section AE 5.01 have not been complied with. This mortgage inspection is made for the exclusive use of the present owners of the property and also those who purchase, mortgage or guarantee the title thereto within one year from date hereof and as to them we certify the accuracy of said mortgage inspection as shown."

Dated this 2nd day of July, 1986.



Roland F. Sarko
Wisconsin Registered Land Surveyor
Number S-1377

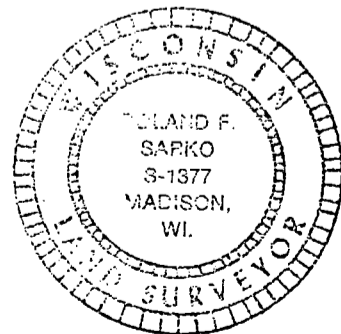

MORTGAGE INSPECTION

R.F. Sarko and Associates, Inc.
Land Surveyors
2919 University Avenue
Madison, Wisconsin 53705

VERNON AVE.

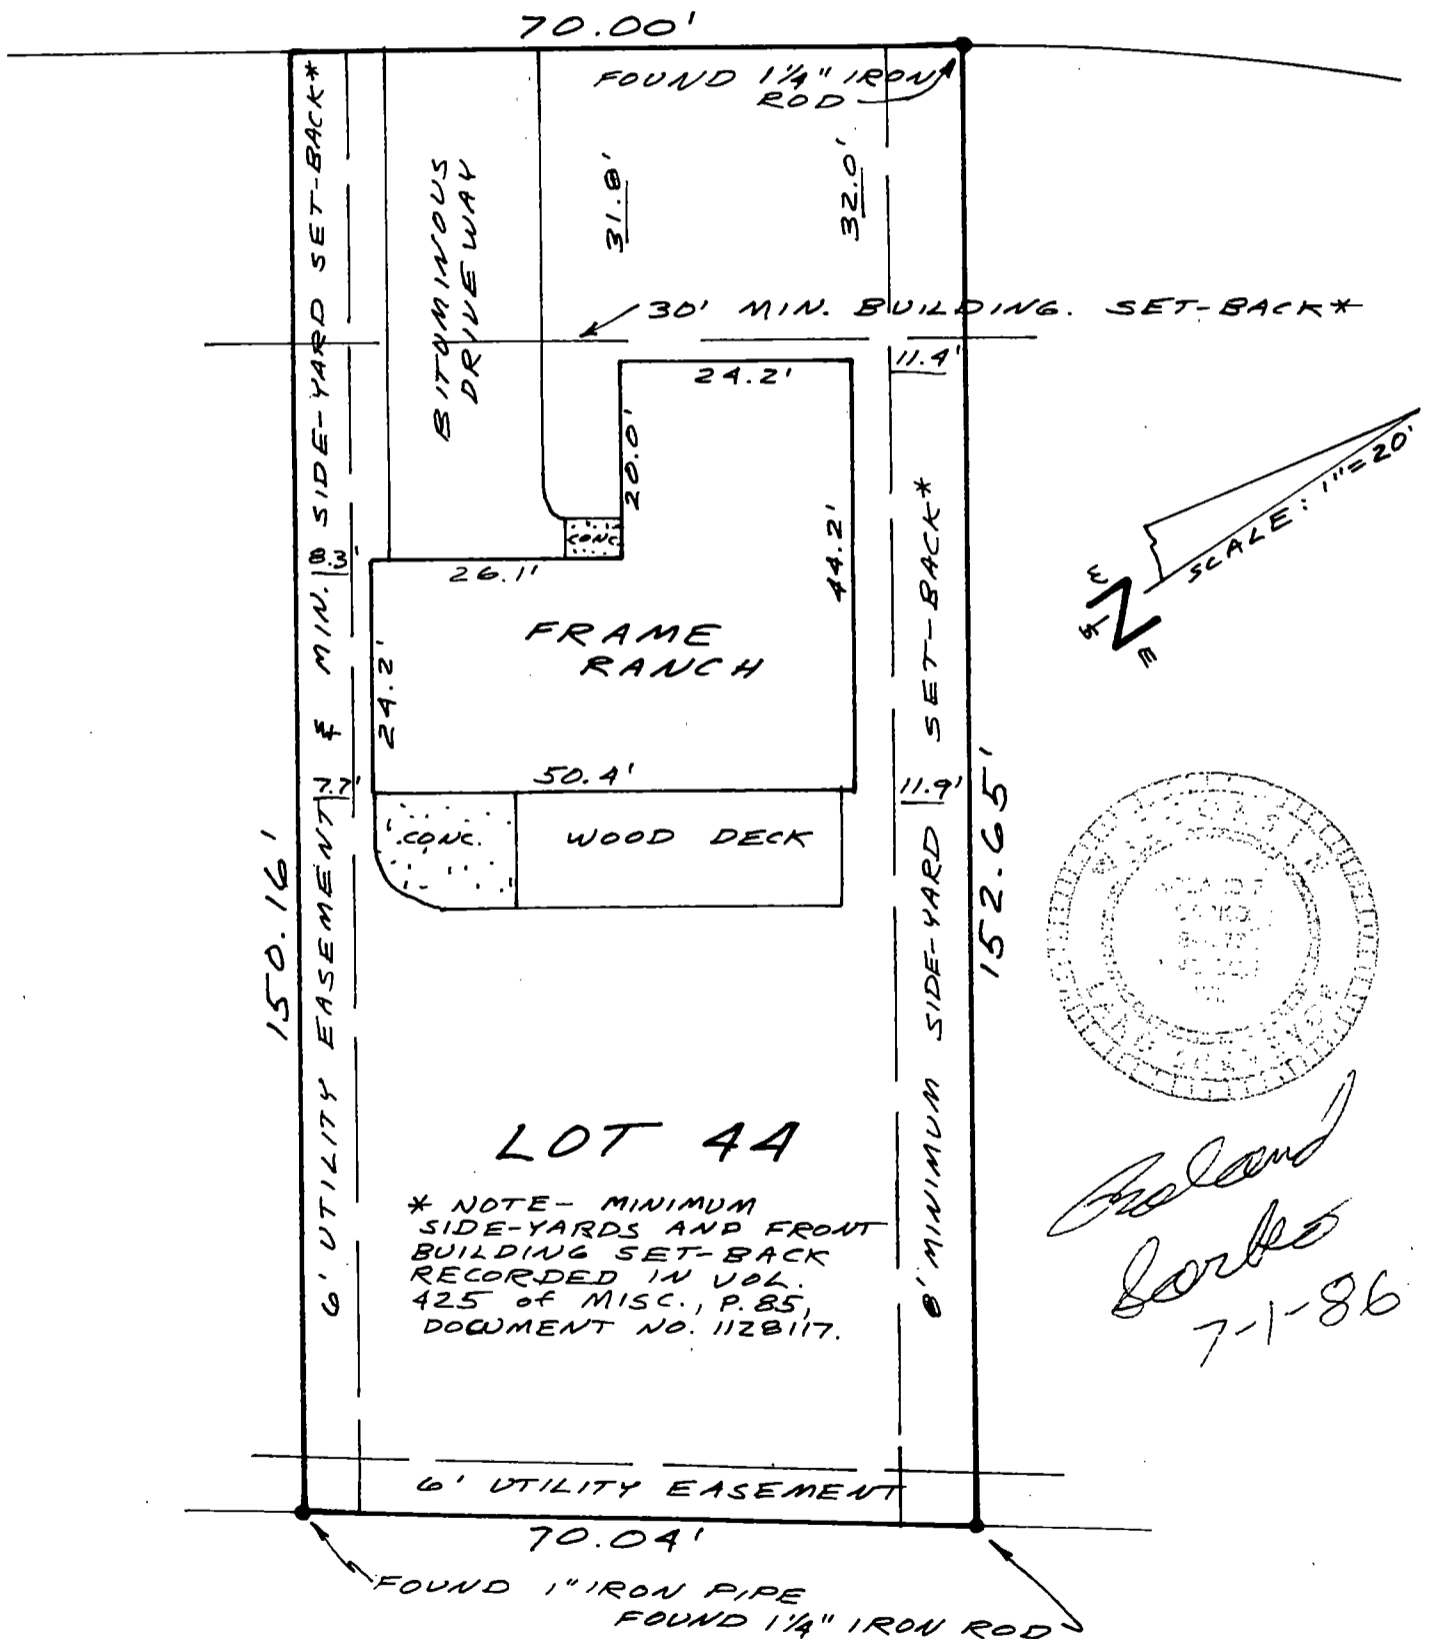

MORTGAGE INSPECTION

R.F. Sarko and Associates, Inc.
Land Surveyors
2919 University Avenue
Madison, Wisconsin 53705

LEGAL DESCRIPTION OF PROPERTY INSPECTED:

Lot 44, Meadowood - East, City of Madison, Dane County, Wisconsin.

ADDRESS OF PROPERTY INSPECTED:

513 Vernon Avenue
Madison, Wisconsin

INSPECTED FOR:

Sears Mortgage Corporation
2901 West Beltline Highway
Madison, Wisconsin 53713

Attn: Beth

COPY TO:

Dane County Title


CLIENT:


Karl and Christine Kleifgen
02-48-21112

CERTIFICATE:

"I, Roland F. Sarko, Registered Land Surveyor in the State of Wisconsin, do hereby certify that I have inspected the above described property and that I have mapped the property according to the official records and that I have mapped the locations of all visible structures, the dimensions of all principal buildings, roadways, apparent easements and visible encroachments, if any. This mortgage inspection has been prepared in accordance with the requirements of the Sears Mortgage Corporation and under an agreement between R.F. Sarko and Associates, Inc. and the Sears Mortgage Corporation which excludes this mortgage inspection from all of the requirements of Section AE 5.01, Wisconsin Administrative Code. Therefore, all of the requirements of Section AE 5.01 have not been complied with. This mortgage inspection is made for the exclusive use of the present owners of the property and also those who purchase, mortgage or guarantee the title thereto within one year from date hereof and as to them we certify the accuracy of said mortgage inspection as shown."



Dated this 1st day of July, 1986.


Roland F. Sarko
Wisconsin Registered Land Surveyor
Number S-1377

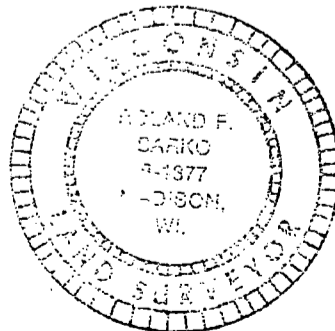


MORTGAGE INSPECTION

R.F. Sarko and Associates, Inc.
Land Surveyors
2919 University Avenue
Madison, Wisconsin 53705

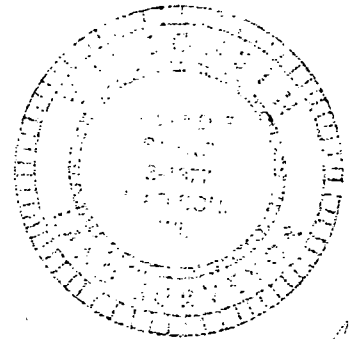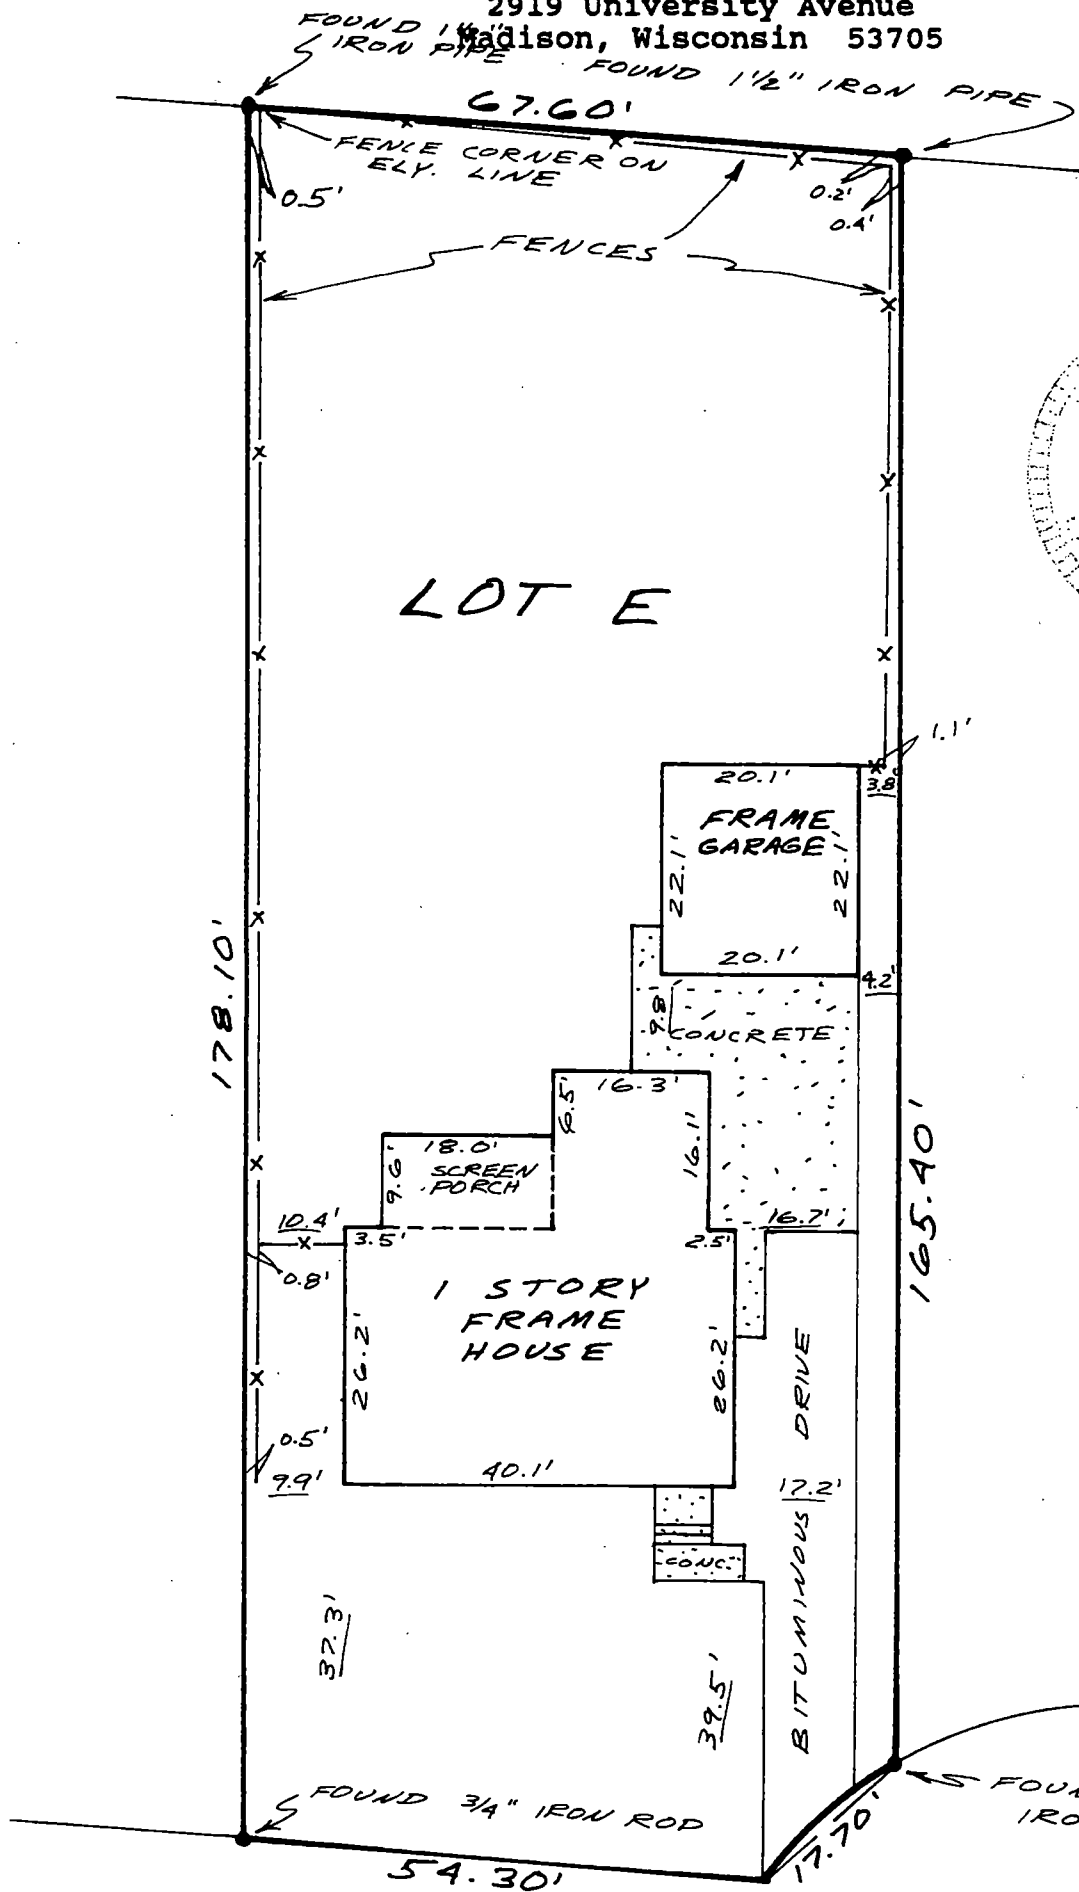

R. Sarko
7-1-86

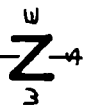SCALE: 1" = 20' 

HEGG AVE.

MORTGAGE INSPECTION

R.F. Sarko and Associates, Inc.
Land Surveyors
2919 University Avenue
Madison, Wisconsin 53705

LEGAL DESCRIPTION OF PROPERTY INSPECTED:

Lot E, Replat of Outlot 11, Blooming Grove Assessor's Plat Number 5, City of Madison, Dane County, Wisconsin.

ADDRESS OF PROPERTY INSPECTED:

4318 Hegg Avenue
Madison, Wisconsin

INSPECTED FOR:

First American Title Insurance Company of Mid-America
1717 West Beltline Highway
Madison, Wisconsin 53713


CLIENT:


Ronald and Mary Friberg
MA-861246-FF

CERTIFICATE:

"I, Roland F. Sarko, Registered Land Surveyor in the State of Wisconsin, do hereby certify that I have inspected the above described property and that I have mapped the property according to the official records and that I have mapped the locations of all visible structures, the dimensions of all principal buildings, roadways, apparent easements and visible encroachments, if any. This mortgage inspection has been prepared in accordance with the requirements of the First American Title Insurance Company of Mid-America and under an agreement between R.F. Sarko and Associates, Inc. and the First American Title Insurance Company of Mid-America which excludes this mortgage inspection from all of the requirements of Section AE 5.01, Wisconsin Administrative Code. Therefore, all of the requirements of Section AE 5.01 have not been complied with. This mortgage inspection is made for the exclusive use of the present owners of the property and also those who purchase, mortgage or guarantee the title thereto within one year from date hereof and as to them we certify the accuracy of said mortgage inspection as shown."

Dated this 1st day of July, 1986.

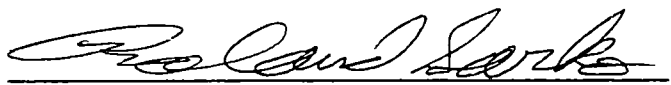

Roland F. Sarko
Wisconsin Registered Land Surveyor
Number S-1377

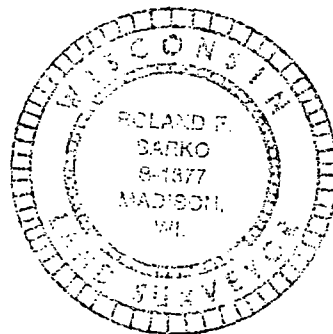


Map Number: 4-17105
Job Number: 12936
Page Two of Two

MORTGAGE INSPECTION

R.F. Sarko and Associates, Inc.
Land Surveyors
2919 University Avenue
Madison, Wisconsin 53705

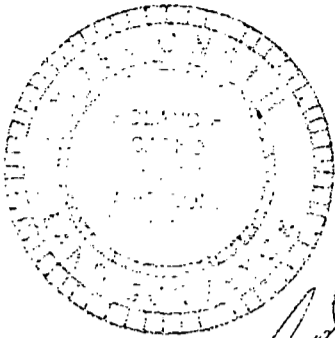

R.F. Sarko
7-1-86

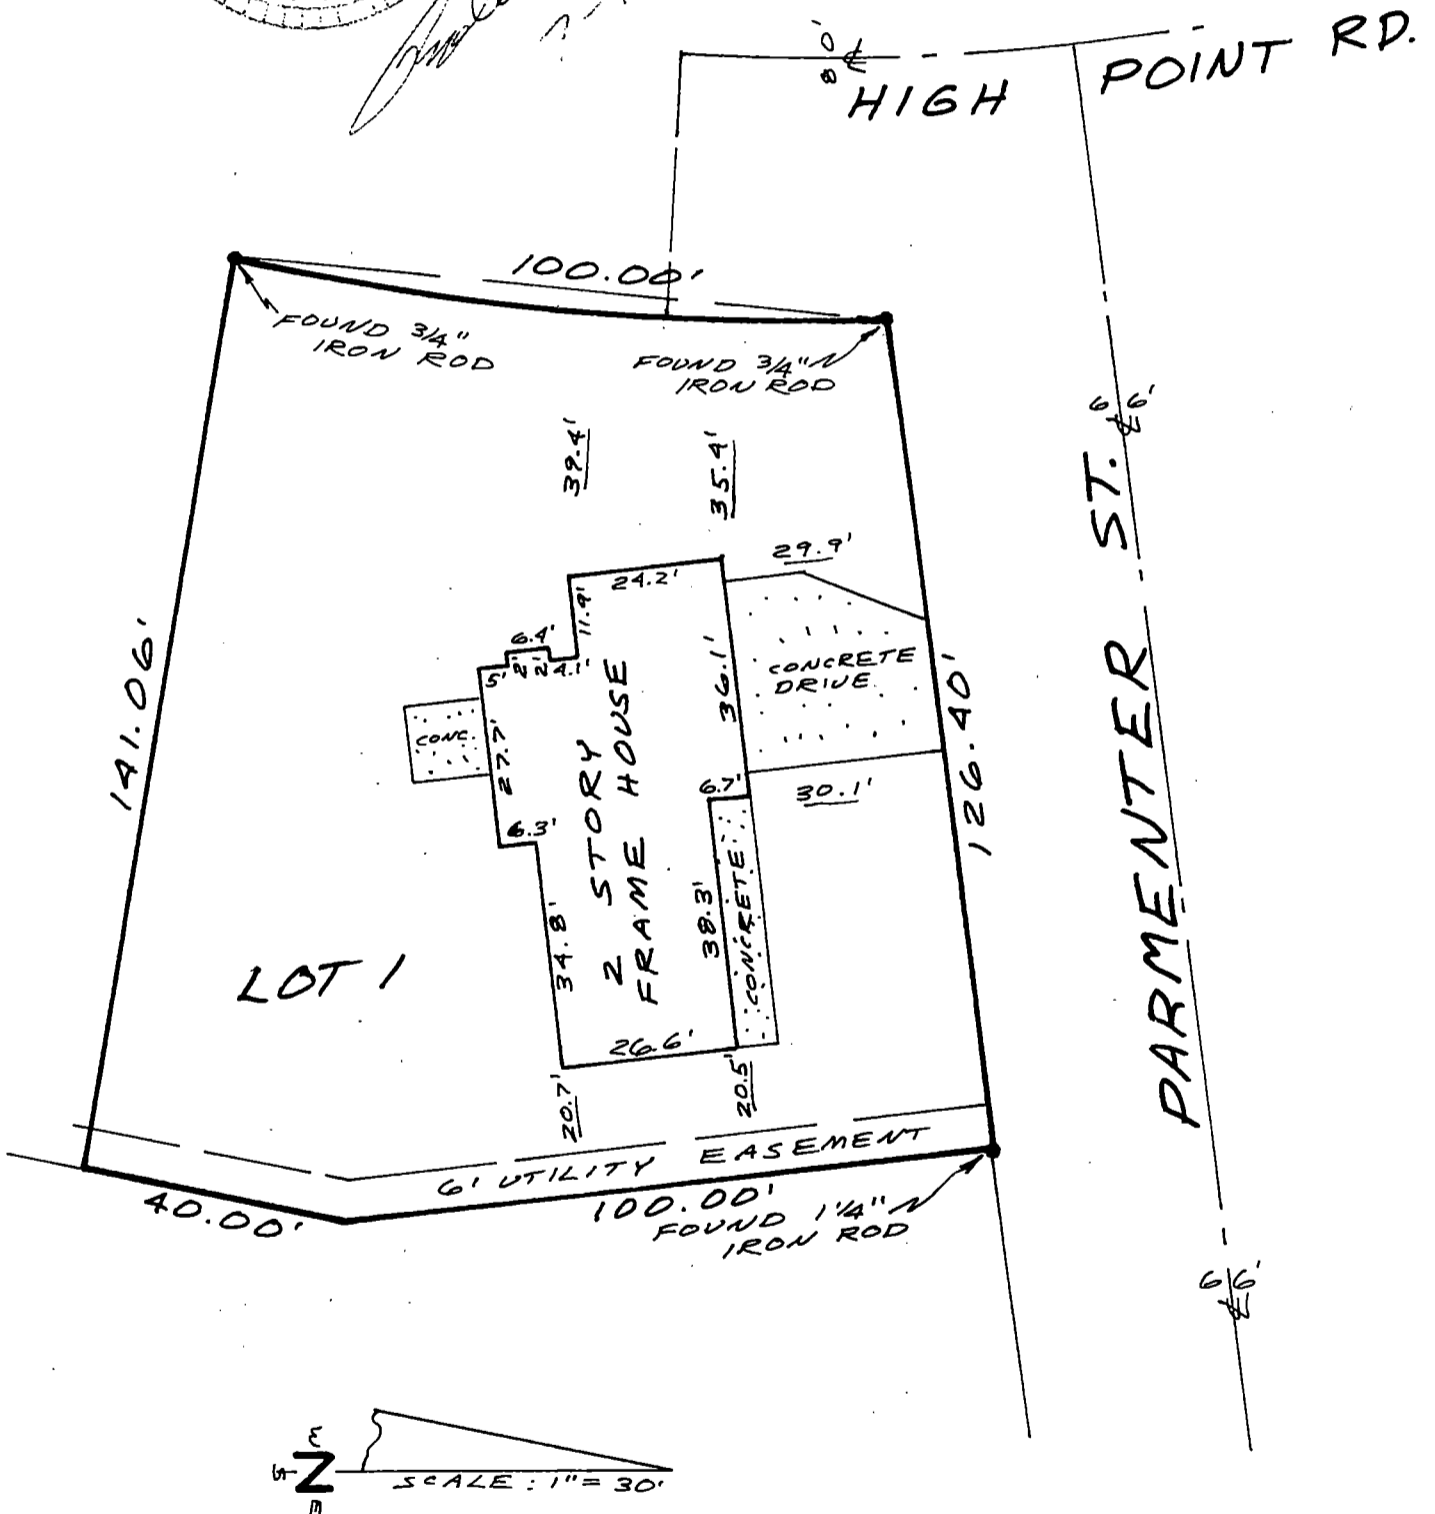

MORTGAGE INSPECTION

R.F. Sarko and Associates, Inc.
Land Surveyors
2919 University Avenue
Madison, Wisconsin 53705

LEGAL DESCRIPTION OF PROPERTY INSPECTED:

Lot 1, Certified Survey Map Number 4927, recorded in Volume 22 of Certified Surveys on Page 48 as Document Number 1933247, City of Middleton, Dane County, Wisconsin.

ADDRESS OF PROPERTY INSPECTED:

Parmenter Street
Middleton, Wisconsin

INSPECTED FOR:

Sears Mortgage Corporation
2901 West Beltline Highway
Madison, Wisconsin 53713

Attn: Elizabeth


CLIENT:


Leo and Karen Neville

CERTIFICATE:

"I, Roland F. Sarko, Registered Land Surveyor in the State of Wisconsin, do hereby certify that I have inspected the above described property and that I have mapped the property according to the official records and that I have mapped the locations of all visible structures, the dimensions of all principal buildings, roadways, apparent easements and visible encroachments, if any. This mortgage inspection has been prepared in accordance with the requirements of the Sears Mortgage Corporation and under an agreement between R.F. Sarko and Associates, Inc. and the Sears Mortgage Corporation which excludes this mortgage inspection from all of the requirements of Section AE 5.01, Wisconsin Administrative Code. Therefore, all of the requirements of Section AE 5.01 have not been complied with. This mortgage inspection is made for the exclusive use of the present owners of the property and also those who purchase, mortgage or guarantee the title thereto within one year from date hereof and as to them we certify the accuracy of said mortgage inspection as shown."

Dated this 1st day of July, 1986.


Roland F. Sarko
Wisconsin Registered Land Surveyor
Number S-1377

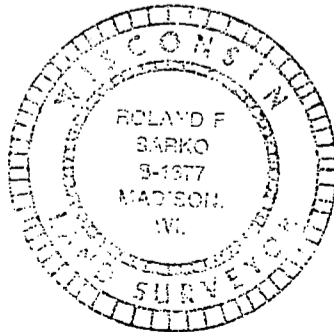


Map Number: 4-17106
Job Number: 13194
Page Two of Two

R.F. Sarko and Associates, Inc.
Land Surveyors
2919 University Avenue
Madison, Wisconsin 53705

R.F. Sarko and Associates, Inc.
Land Surveyors
2919 University Avenue
Madison, Wisconsin 53705

A hand-drawn sketch of a triangular plot. A north arrow is drawn pointing towards the upper left, with the letter 'N' and the word 'North' written next to it. The scale is indicated as "SCALE: 1" = 20'".

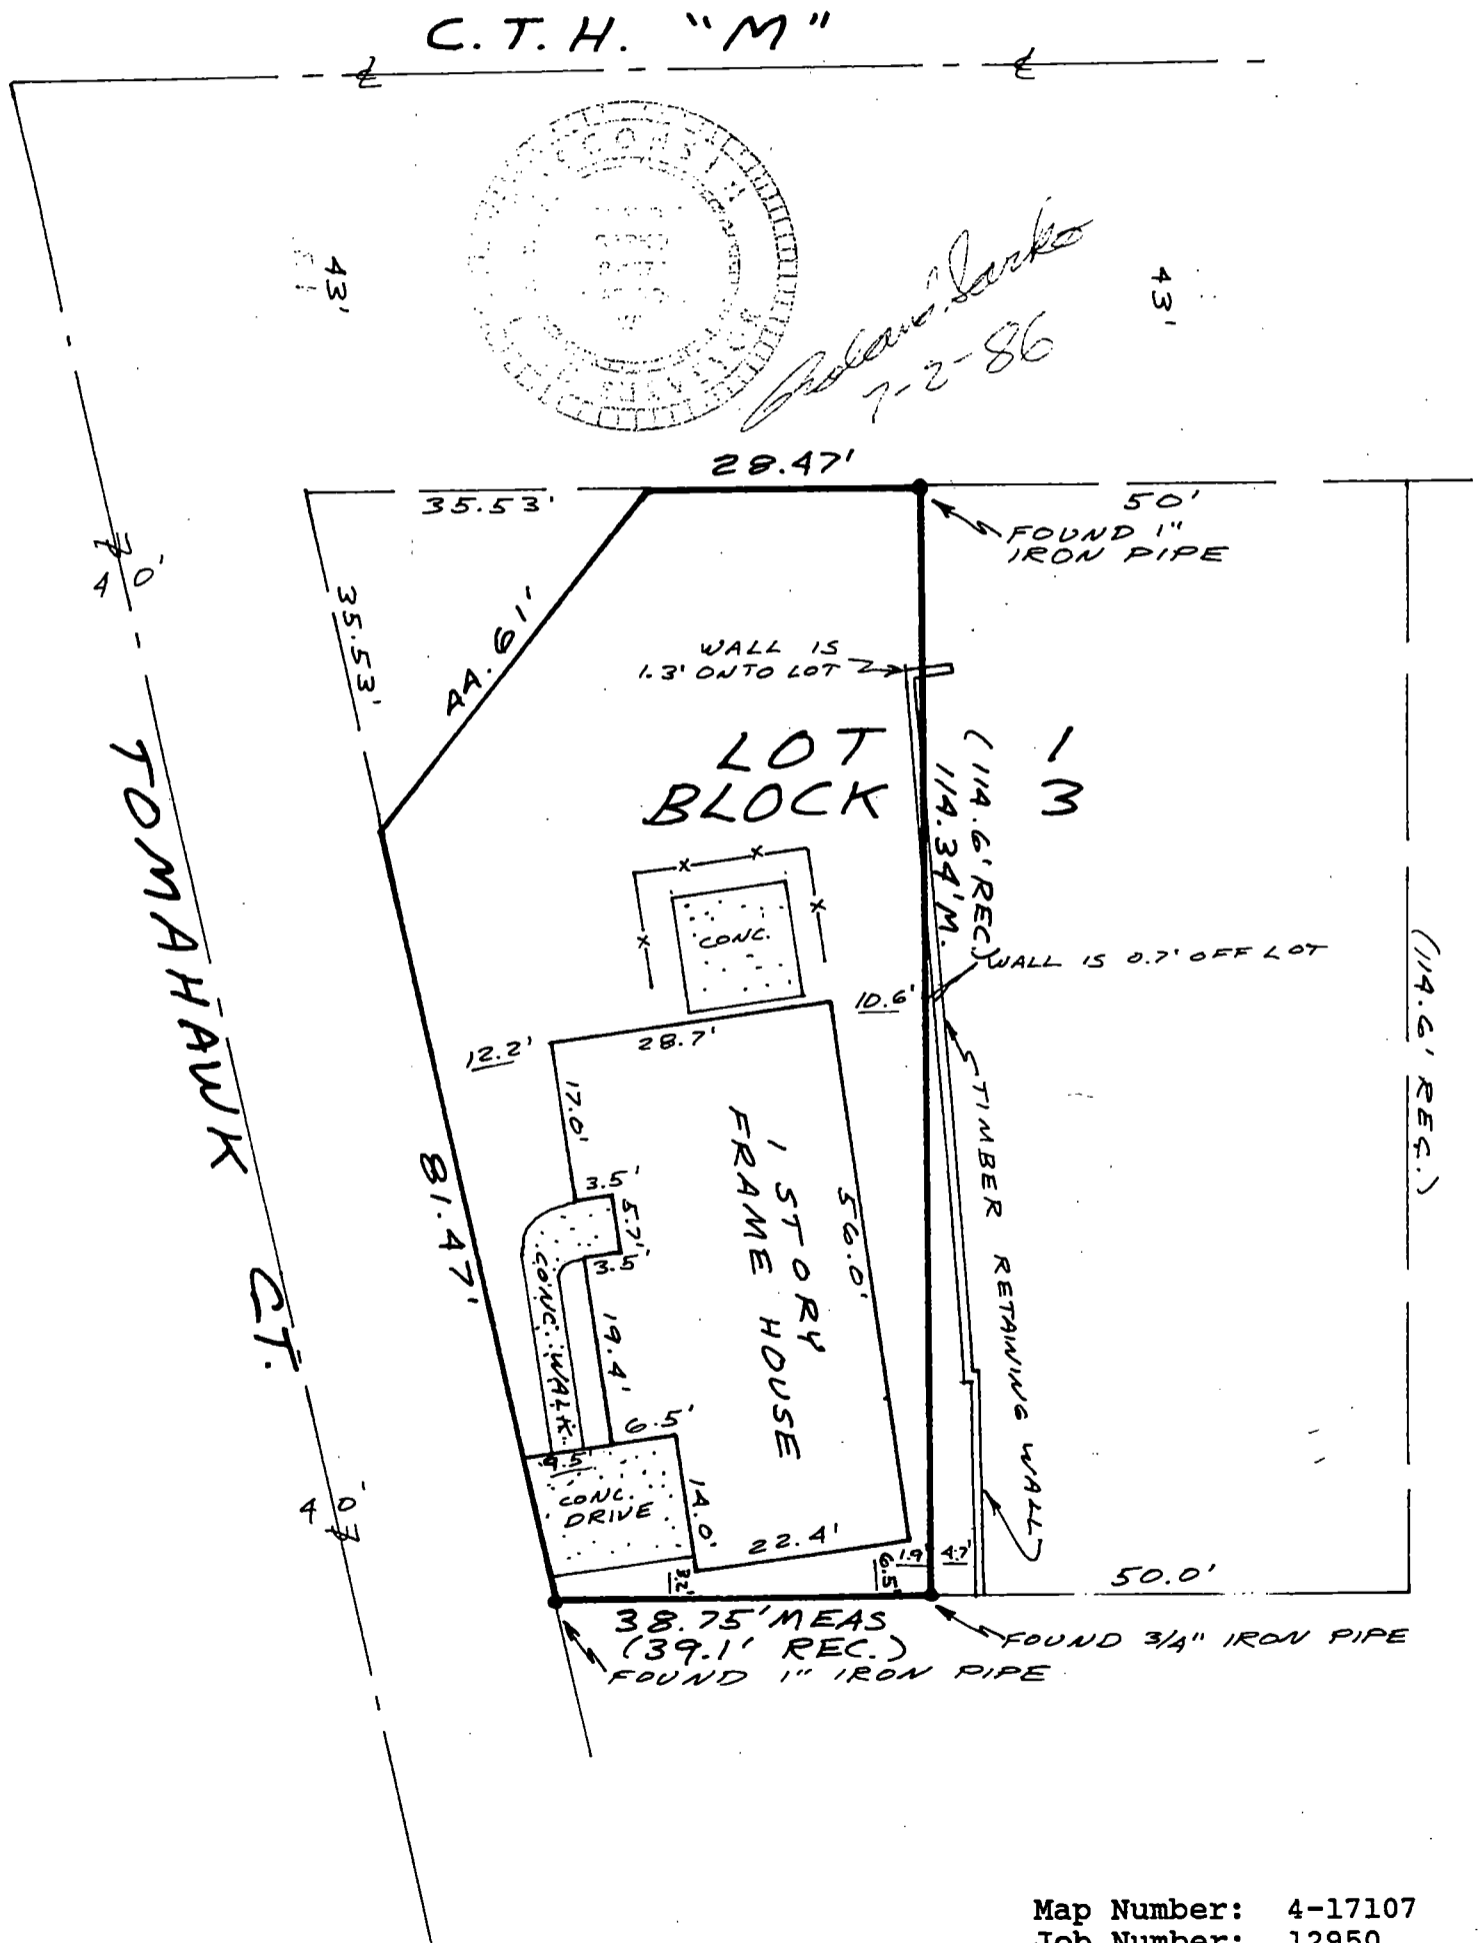

MORTGAGE INSPECTION

R.F. Sarko and Associates, Inc.

Land Surveyors

2919 University Avenue

Madison, Wisconsin 53705

LEGAL DESCRIPTION OF PROPERTY INSPECTED:

Lot 1, Block 3, except the Easterly 50.00 feet thereof, Assessor's Plat of Baskerville Harbor, City of Middleton, Dane County Wisconsin, except the parcel conveyed for highway purposes, recorded in Volume 285 of Miscellaneous on Page 519 as Document Number 908027, Dane County Registry.

ADDRESS OF PROPERTY INSPECTED:

2949 Tomahawk Court
Middleton, Wisconsin

INSPECTED FOR:

Sears Mortgage Corporation
2901 West Beltline Highway
Madison, Wisconsin 53713


Attn: Elizabeth

COPY TO:

Preferred Title

CLIENT:

David Statz
09-48-21298

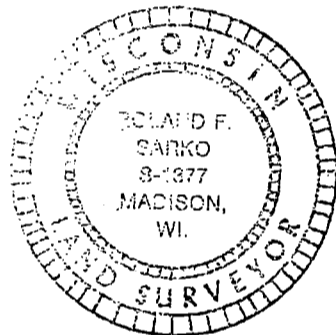

CERTIFICATE:

"I, Roland F. Sarko, Registered Land Surveyor in the State of Wisconsin, do hereby certify that I have inspected the above described property and that I have mapped the property according to the official records and that I have mapped the locations of all visible structures, the dimensions of all principal buildings, roadways, apparent easements and visible encroachments, if any. This mortgage inspection has been prepared in accordance with the requirements of the Sears Mortgage Corporation and under an agreement between R.F. Sarko and Associates, Inc. and the Sears Mortgage Corporation which excludes this mortgage inspection from all of the requirements of Section AE 5.01, Wisconsin Administrative Code. Therefore, all of the requirements of Section AE 5.01 have not been complied with. This mortgage inspection is made for the exclusive use of the present owners of the property and also those who purchase, mortgage or guarantee the title thereto within one year from date hereof and as to them we certify the accuracy of said mortgage inspection as shown."



Dated this 2nd day of July, 1986.

A handwritten signature in cursive script that reads "Roland F. Sarko".

Roland F. Sarko
Wisconsin Registered Land Surveyor
Number S-1377

MORTGAGE INSPECTION

R.F. Sarko and Associates, Inc.
Land Surveyors
2919 University Avenue
Madison, Wisconsin 53705

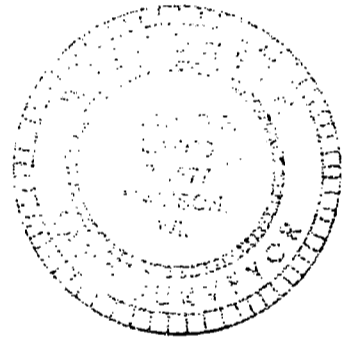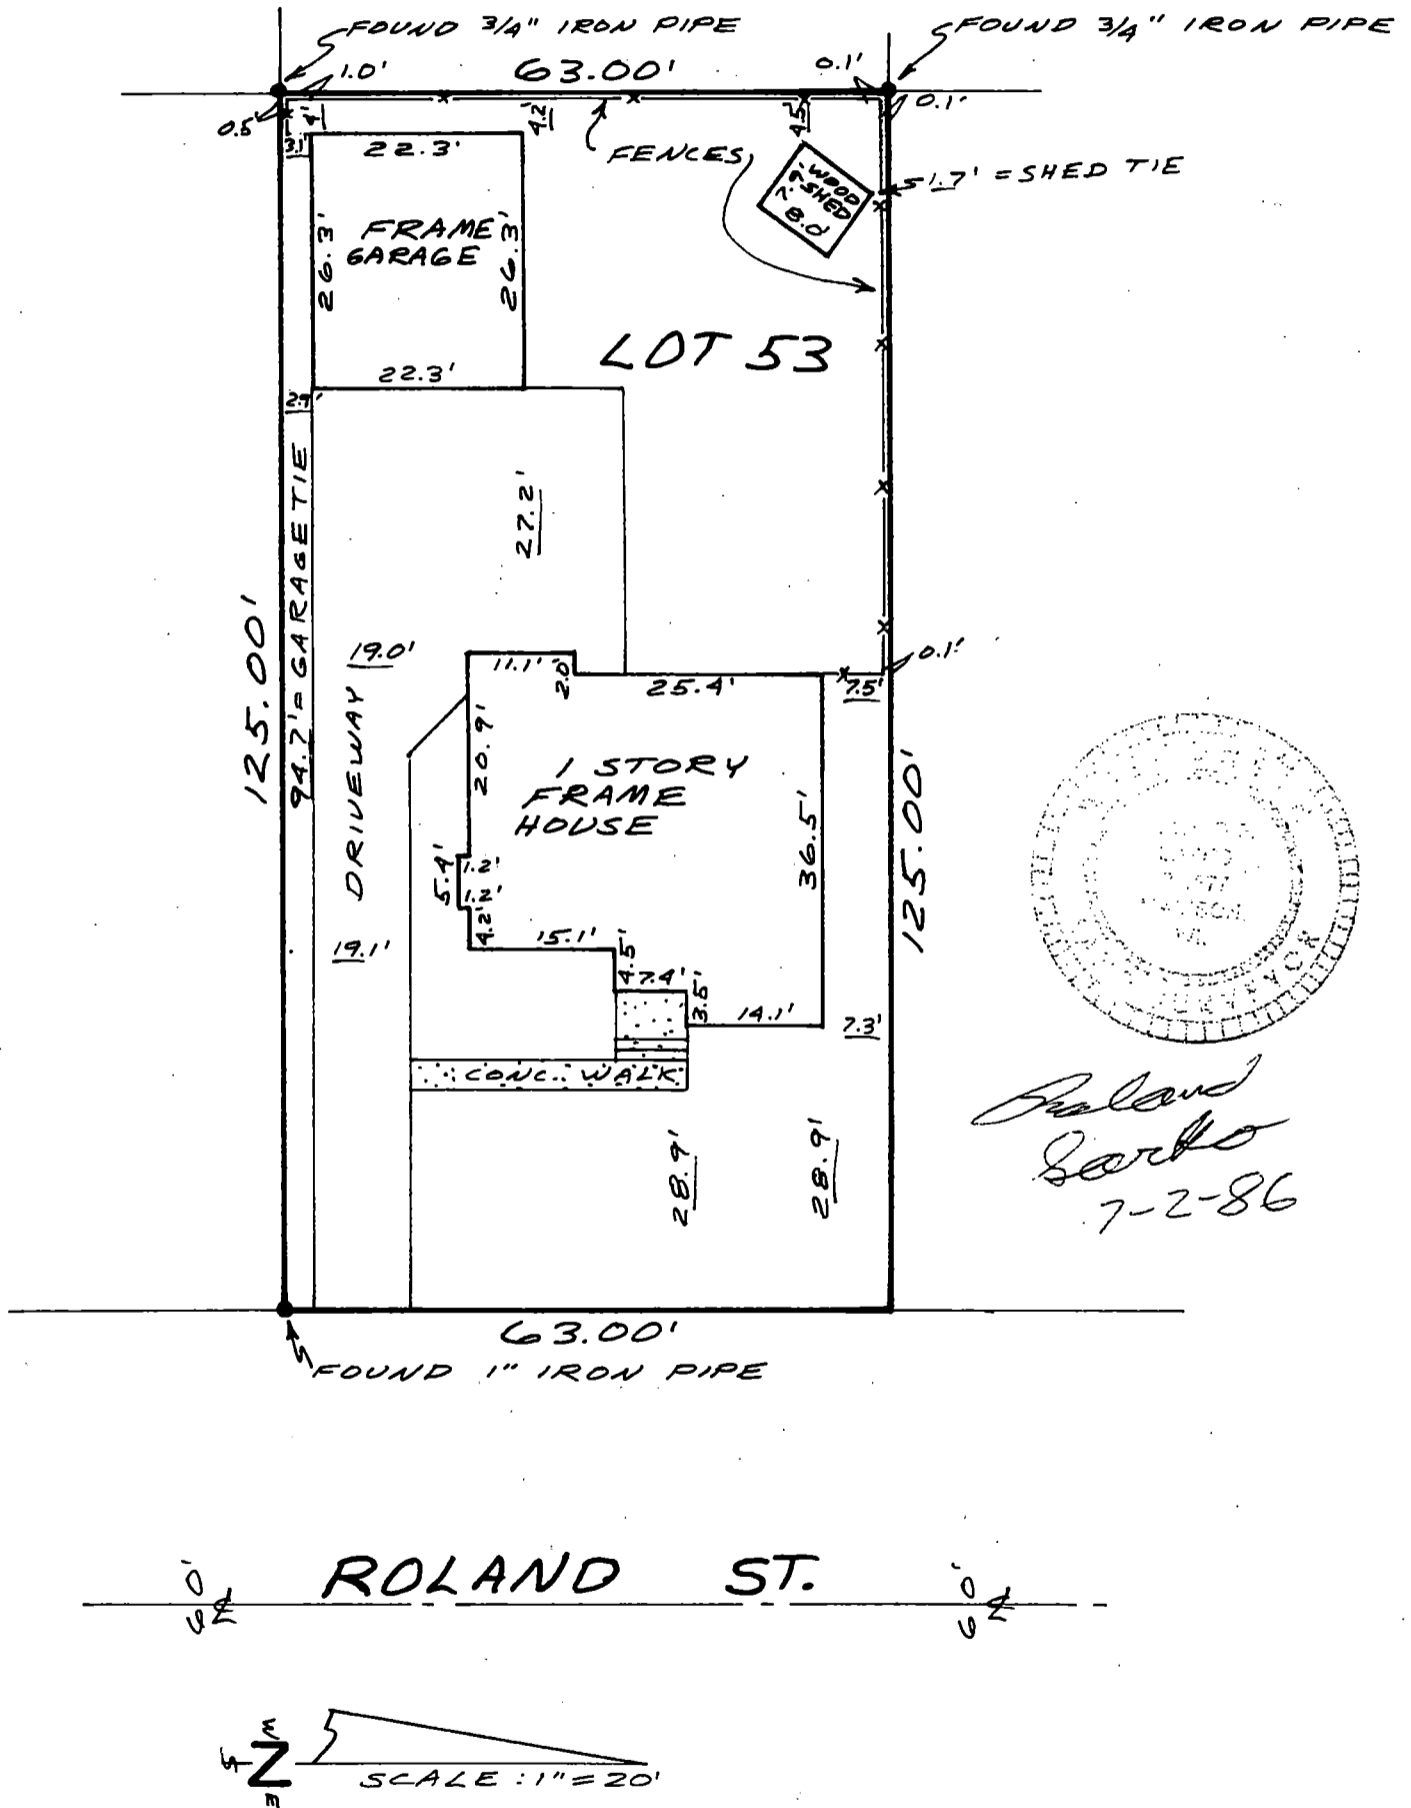

Roland Sarko
7-2-86

MORTGAGE INSPECTION

R.F. Sarko and Associates, Inc.
Land Surveyors
2919 University Avenue
Madison, Wisconsin 53705

LEGAL DESCRIPTION OF PROPERTY INSPECTED:

Lot 53, E.M. Strasburg Addition, City of Sun Prairie, Dane County, Wisconsin.

ADDRESS OF PROPERTY INSPECTED:

151 Roland Street
Sun Prairie, Wisconsin

INSPECTED FOR:

Anchor Savings and Loan Association
216 Cottage Grove Road
Madison, Wisconsin 53716

Attn:
Paul


CLIENT:


Mischael L. Humphry

CERTIFICATE:

"I, Roland F. Sarko, Registered Land Surveyor in the State of Wisconsin, do hereby certify that I have inspected the above described property and that I have mapped the property according to the official records and that I have mapped the locations of all visible structures, the dimensions of all principal buildings, roadways, apparent easements and visible encroachments, if any. This mortgage inspection has been prepared in accordance with the requirements of the Anchor Savings and Loan Association and under an agreement between R.F. Sarko and Associates, Inc. and the Anchor Savings and Loan Association which excludes this mortgage inspection from all of the requirements of Section AE 5.01, Wisconsin Administrative Code. Therefore, all of the requirements of Section AE 5.01 have not been complied with. This mortgage inspection is made for the exclusive use of the present owners of the property and also those who purchase, mortgage or guarantee the title thereto within one year from date hereof and as to them we certify the accuracy of said mortgage inspection as shown."

Dated this 2nd day of July, 1986.


Roland F. Sarko
Wisconsin Registered Land Surveyor
Number S-1377

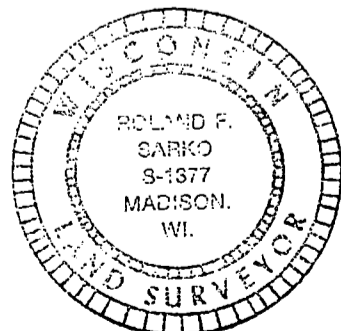


Map Number: 4-17108
Job Number: 12815
Page Two of Two

R.F. Sarko and Associates, Inc.
Land Surveyors
2919 University Avenue
Madison, Wisconsin 53705



Richard L. Larkin
7-2-86

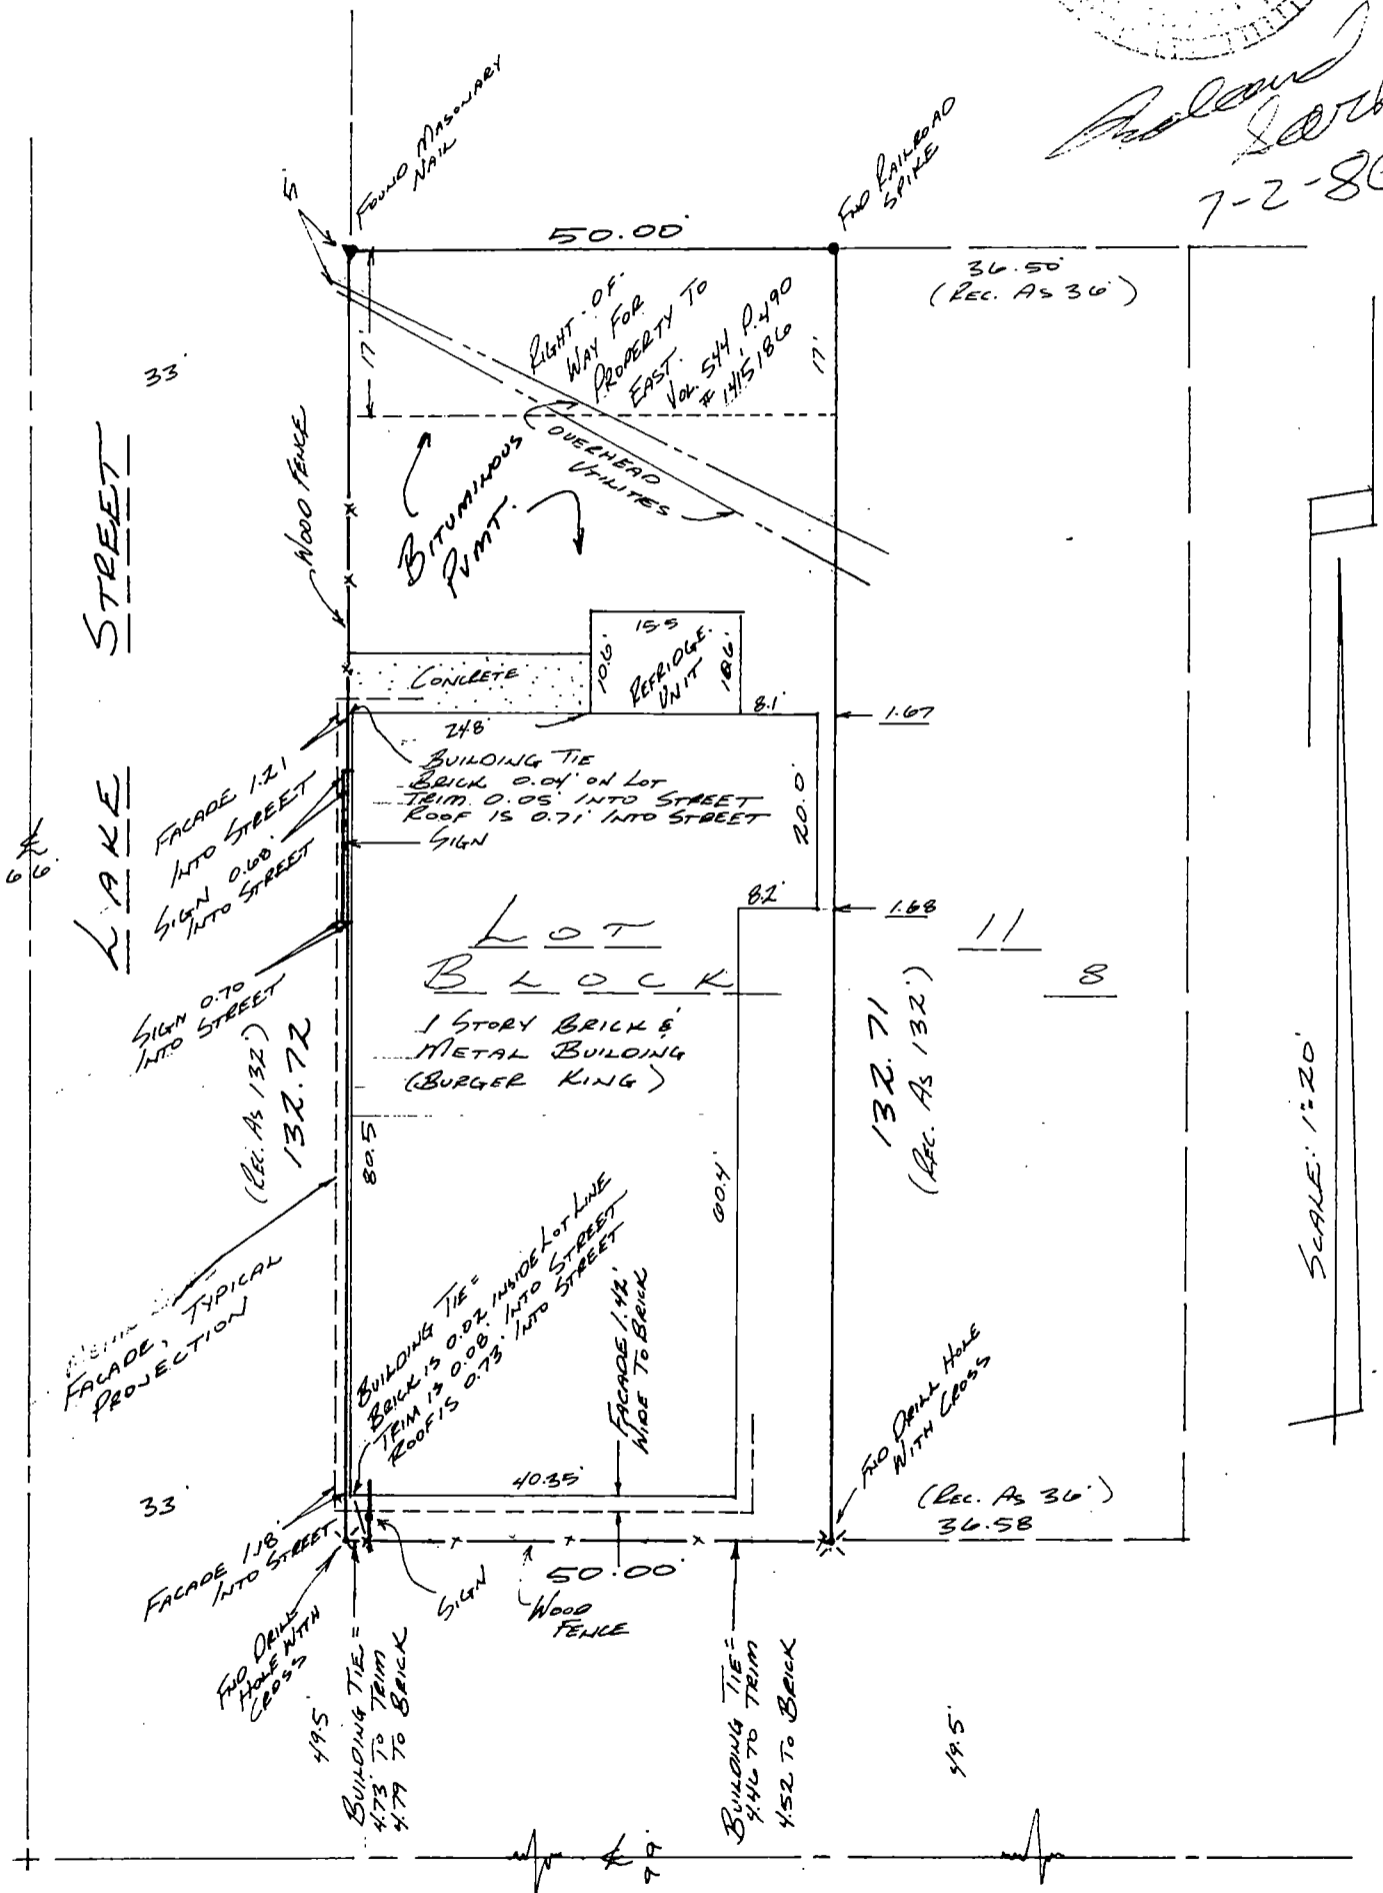

UNIVERSITY AVENUE Map 566

Map Number: 4-17110
~~File~~ Number: 13040
Page One of Two

MORTGAGE INSPECTION

R.F. Sarko and Associates, Inc.
Land Surveyors
2919 University Avenue
Madison, Wisconsin 53705

LEGAL DESCRIPTION OF PROPERTY INSPECTED:

The West 50.00 feet of Lot 11, Block 8, University Addition,
City of Madison, Dane County, Wisconsin.

ADDRESS OF PROPERTY INSPECTED:

632 University Avenue
Madison, Wisconsin

INSPECTED FOR:

The Bank of Middleton
7448 Hubbard Avenue
Middleton, Wisconsin 53562

Attn:
Jim Van Lieshout


CLIENT:


Steve Banaszak

CERTIFICATE:

"I, Roland F. Sarko, Registered Land Surveyor in the State of Wisconsin, do hereby certify that I have inspected the above described property and that I have mapped the property according to the official records and that I have mapped the locations of all visible structures, the dimensions of all principal buildings, roadways, apparent easements and visible encroachments, if any. This mortgage inspection has been prepared in accordance with the requirements of The Bank of Middleton and under an agreement between R.F. Sarko and Associates, Inc. and The Bank of Middleton which excludes this mortgage inspection from all of the requirements of Section AE 5.01, Wisconsin Administrative Code. Therefore, all of the requirements of Section AE 5.01 have not been complied with. This mortgage inspection is made for the exclusive use of the present owners of the property and also those who purchase, mortgage or guarantee the title thereto within one year from date hereof and as to them we certify the accuracy of said mortgage inspection as shown."

Dated this 2nd day of July, 1986.



Roland F. Sarko
Wisconsin Registered Land Surveyor
Number S-1377

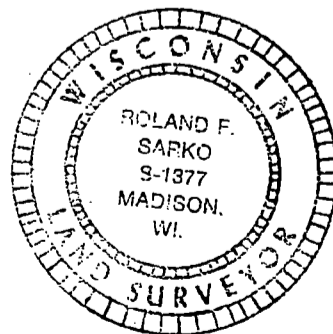


Map Number: 4-17110
Job Number: 13040
Page Two of Two

R.F. Sarko and Associates, Inc.
Land Surveyors
2919 University Avenue
Madison, Wisconsin 53705

R.F. Sarko and Associates, Inc.
Land Surveyors
2919 University Avenue
Madison, Wisconsin 53705

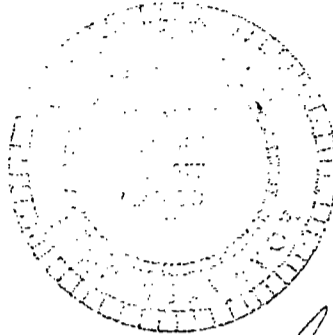


 Ireland
 Lark
 7-1-86

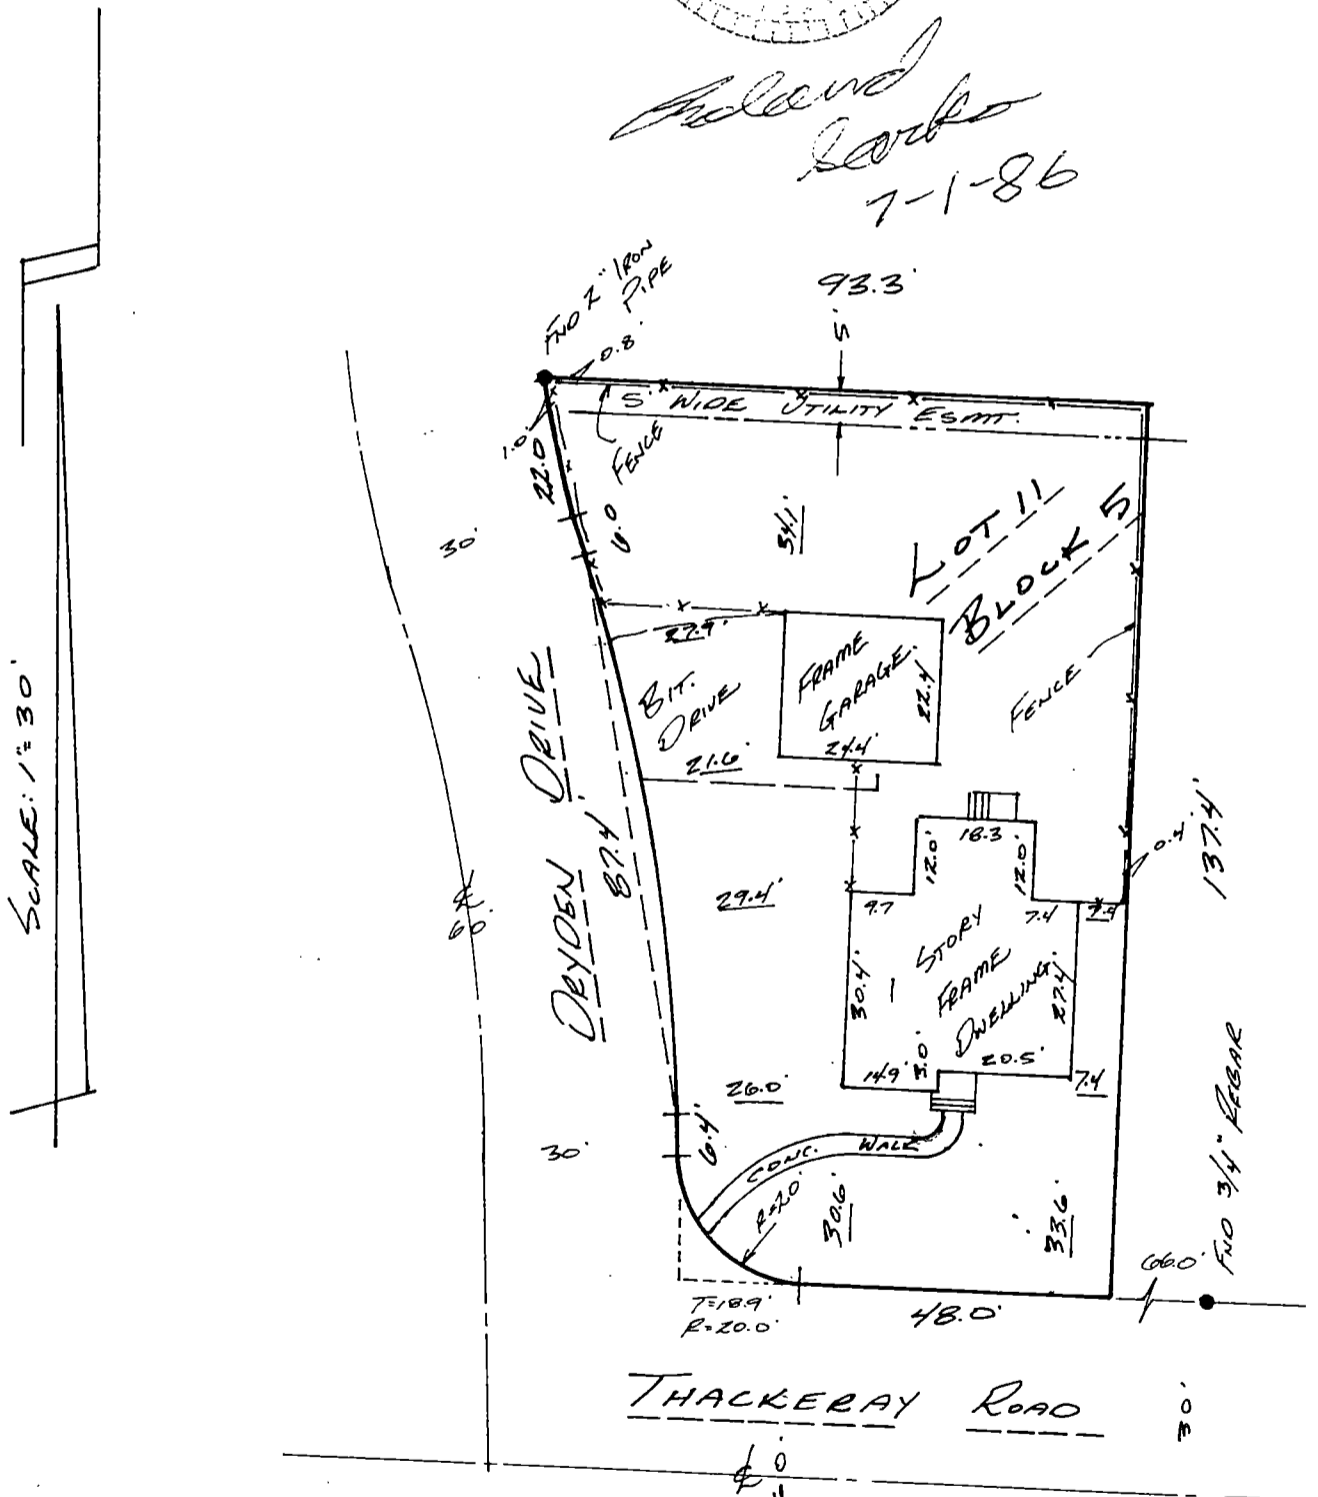

MORTGAGE INSPECTION

R.F. Sarko and Associates, Inc.
Land Surveyors
2919 University Avenue
Madison, Wisconsin 53705

LEGAL DESCRIPTION OF PROPERTY INSPECTED:

Lot 11, Block 5, Berkeley Plat, City of Madison, Dane County,
Wisconsin.

ADDRESS OF PROPERTY INSPECTED:

1902 Thackeray Road
Madison, Wisconsin

INSPECTED FOR:

Sears Mortgage Corporation
2901 West Beltline Highway
Madison, Wisconsin 53713

Attn: Beth

COPY TO:

Preferred Title


CLIENT:


Artha Thexton and Krista Roys

CERTIFICATE:

"I, Roland F. Sarko, Registered Land Surveyor in the State of Wisconsin, do hereby certify that I have inspected the above described property and that I have mapped the property according to the official records and that I have mapped the locations of all visible structures, the dimensions of all principal buildings, roadways, apparent easements and visible encroachments, if any. This mortgage inspection has been prepared in accordance with the requirements of the Sears Mortgage Corporation and under an agreement between R.F. Sarko and Associates, Inc. and the Sears Mortgage Corporation which excludes this mortgage inspection from all of the requirements of Section AE 5.01, Wisconsin Administrative Code. Therefore, all of the requirements of Section AE 5.01 have not been complied with. This mortgage inspection is made for the exclusive use of the present owners of the property and also those who purchase, mortgage or guarantee the title thereto within one year from date hereof and as to them we certify the accuracy of said mortgage inspection as shown."

Dated this 1st day of July, 1986.


Roland F. Sarko
Wisconsin Registered Land Surveyor
Number S-1377

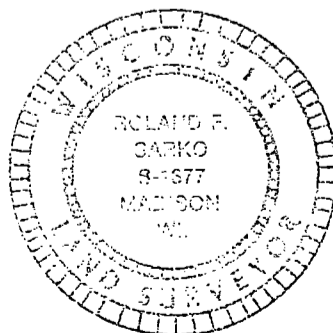


Map Number: 4-17111
Job Number: 12752
Page Two of Two

MORTGAGE INSPECTION


R.F. Sarko and Associates, Inc.
Land Surveyors
2919 University Avenue
Madison, Wisconsin 53705



SCALE: 1" = 20'

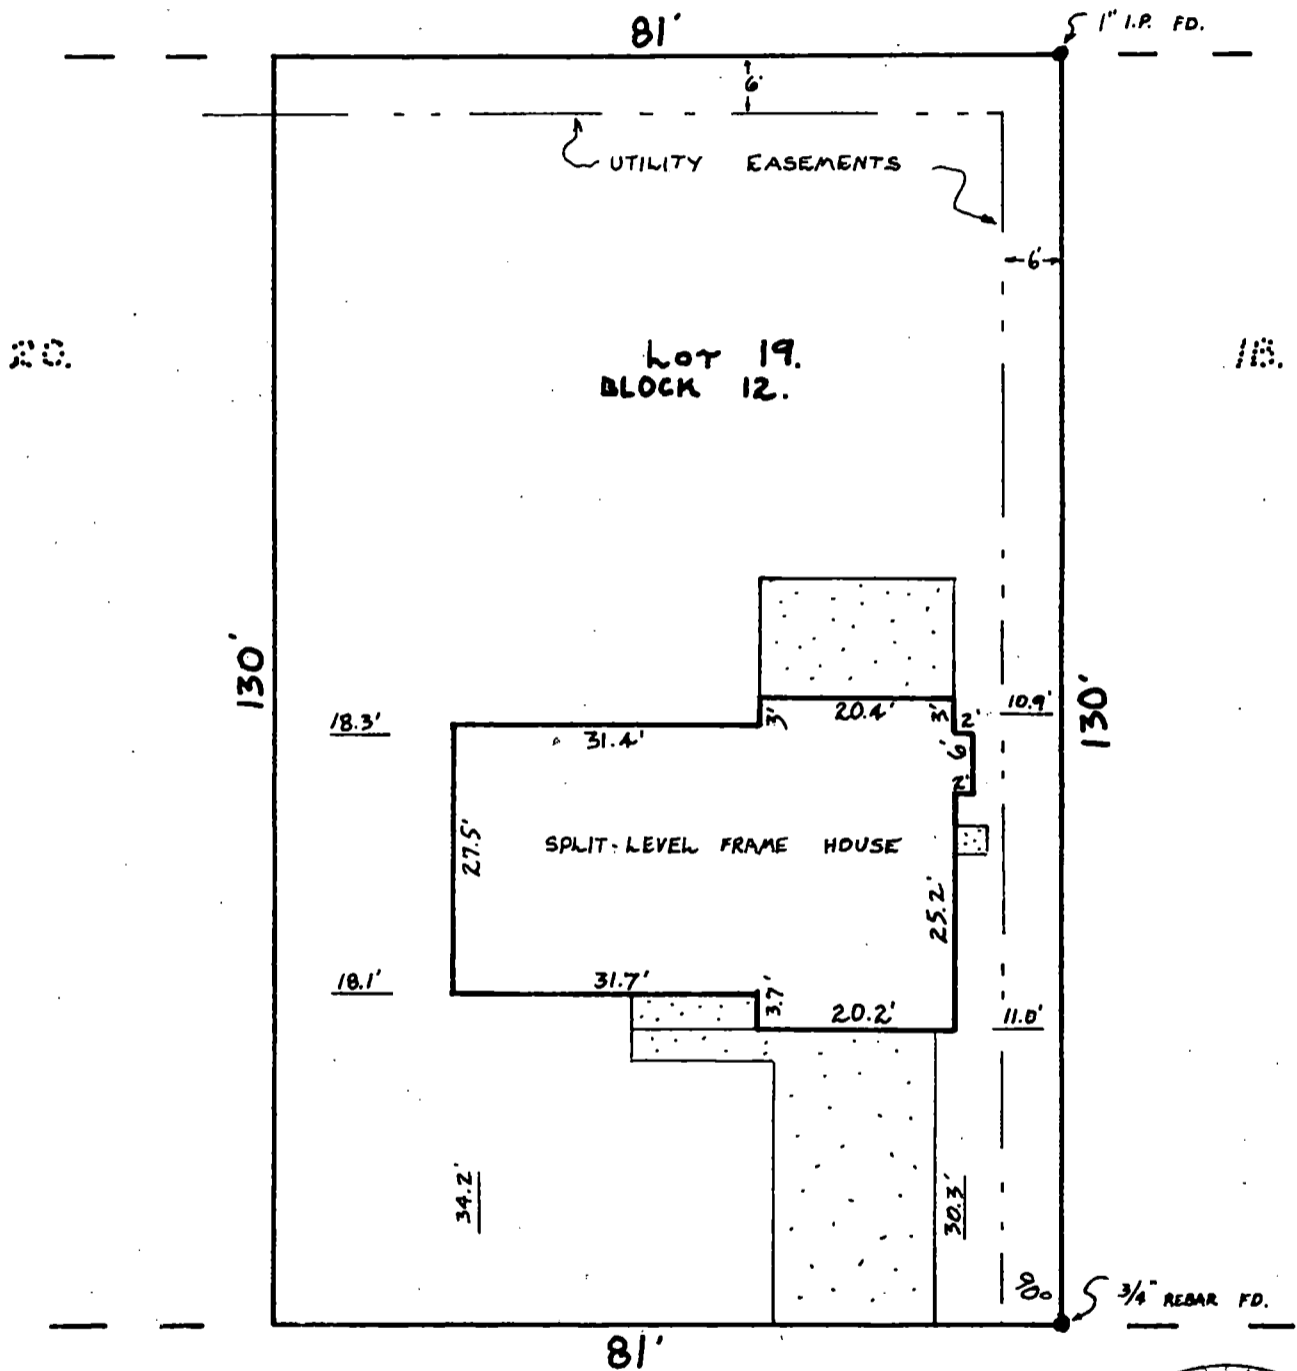

WHITEHALL DR.

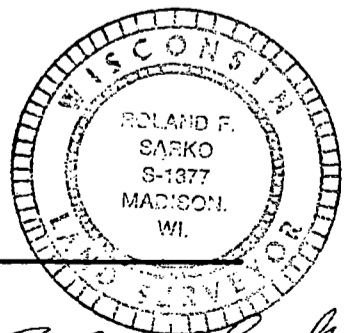

Roland Sarko
7-1-86

Map Number: 4-17112
Job Number: 13018
Page One of Two

MORTGAGE INSPECTION

R.F. Sarko and Associates, Inc.
Land Surveyors
2919 University Avenue
Madison, Wisconsin 53705

LEGAL DESCRIPTION OF PROPERTY INSPECTED:

Lot 19, Block 12, Third Addition to Heritage Heights, City of
Madison, Dane County, Wisconsin.

ADDRESS OF PROPERTY INSPECTED:

626 Whitehall Drive
Madison, Wisconsin

INSPECTED FOR:

Sears Mortgage Corporation
2901 West Beltline Highway
Madison, Wisconsin 53713

Attn: Beth

COPY TO:

Badger Abstract


CLIENT:


Rodney & Joyce Phelps
09-48-21329

CERTIFICATE:

"I, Roland F. Sarko, Registered Land Surveyor in the State of Wisconsin, do hereby certify that I have inspected the above described property and that I have mapped the property according to the official records and that I have mapped the locations of all visible structures, the dimensions of all principal buildings, roadways, apparent easements and visible encroachments, if any. This mortgage inspection has been prepared in accordance with the requirements of the Sears Mortgage Corporation and under an agreement between R.F. Sarko and Associates, Inc. and the Sears Mortgage Corporation which excludes this mortgage inspection from all of the requirements of Section AE 5.01, Wisconsin Administrative Code. Therefore, all of the requirements of Section AE 5.01 have not been complied with. This mortgage inspection is made for the exclusive use of the present owners of the property and also those who purchase, mortgage or guarantee the title thereto within one year from date hereof and as to them we certify the accuracy of said mortgage inspection as shown."

Dated this 1st day of July, 1986.




Roland F. Sarko
Wisconsin Registered Land Surveyor
Number S-1377

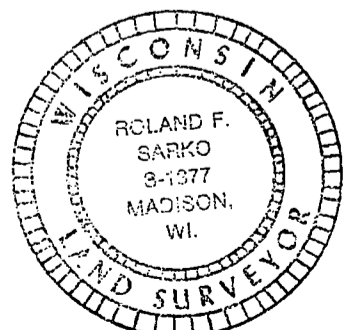


Map Number: 4-17112
Job Number: 13018
Page Two of Two

MORTGAGE INSPECTION

R.F. Sarko and Associates, Inc.
Land Surveyors
2919 University Avenue
Madison, Wisconsin 53705

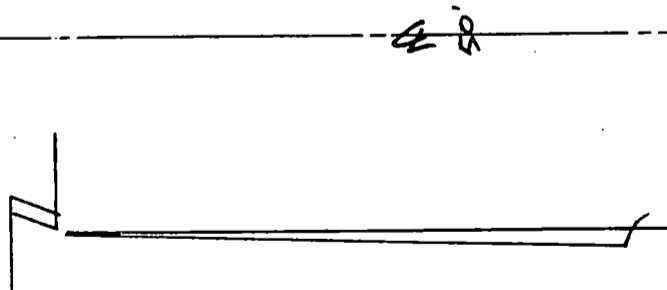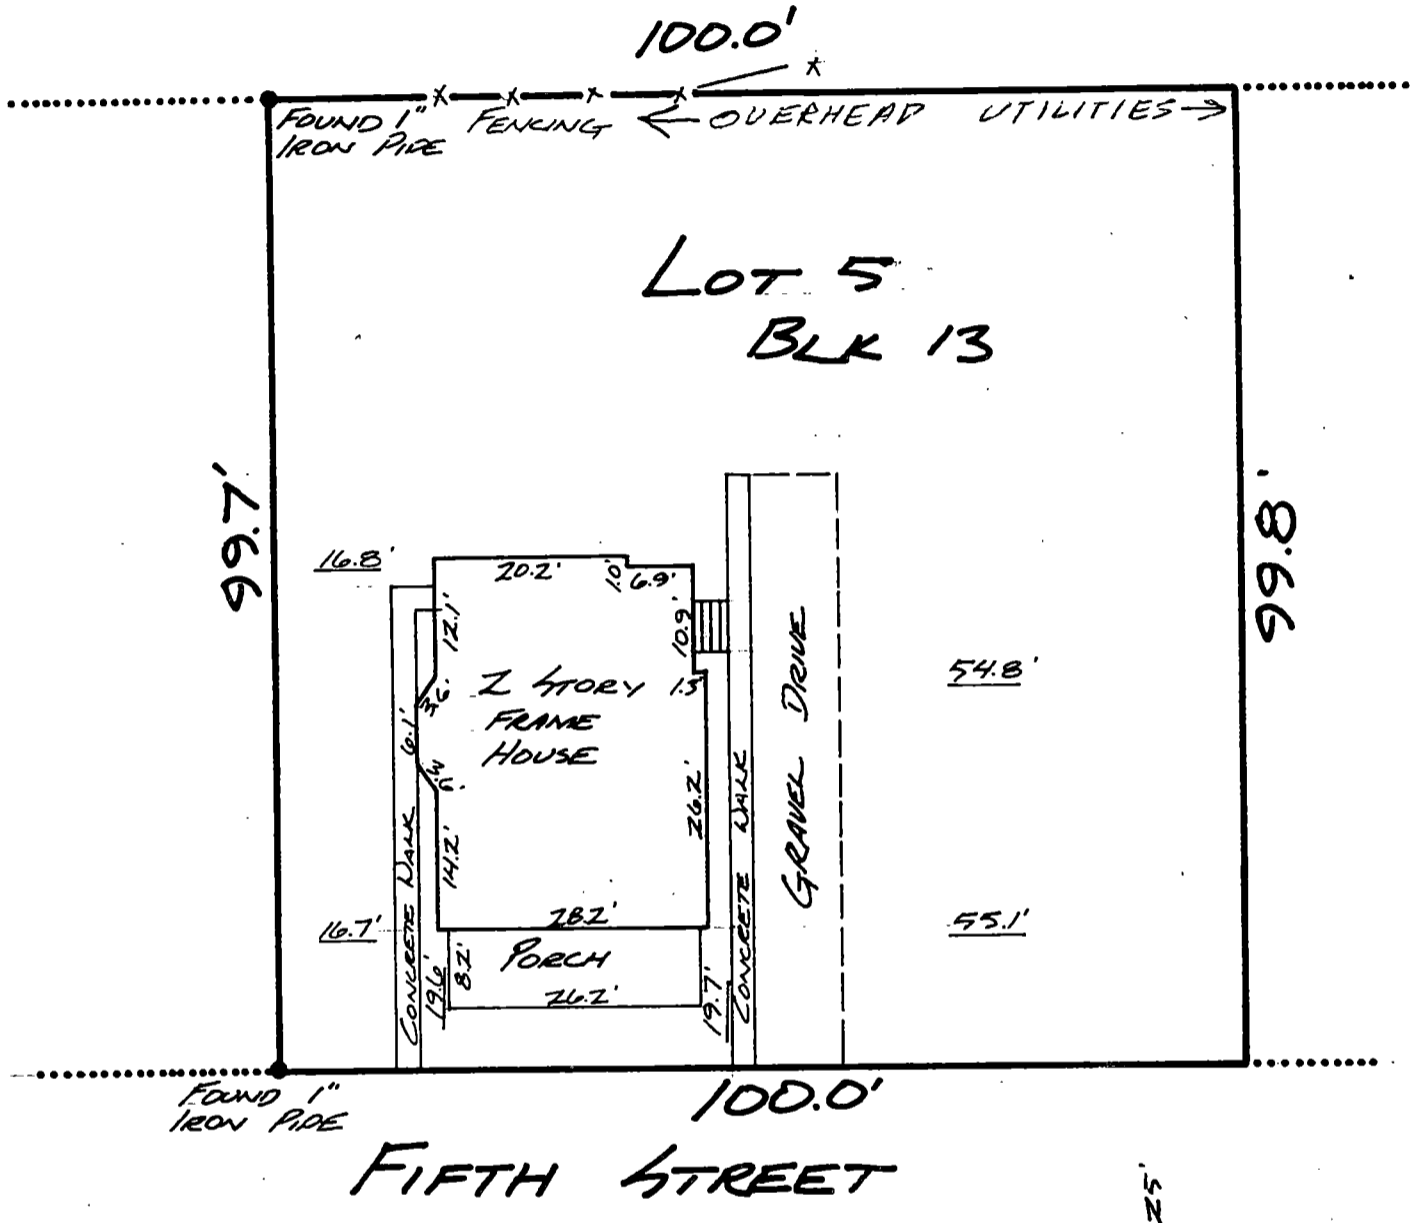

SCALE: 1"=20'

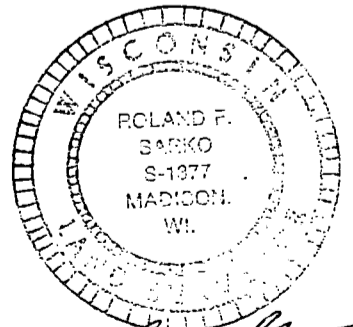

Roland Sarko
7-1-86

MORTGAGE INSPECTION

R.F. Sarko and Associates, Inc.
Land Surveyors
2919 University Avenue
Madison, Wisconsin 53705

LEGAL DESCRIPTION OF PROPERTY INSPECTED:

Lot 5, Block 13, Plat of Blocks 12 & 13 of Lingard's Addition
to the Village of Mount Horeb, Dane County, Wisconsin.

ADDRESS OF PROPERTY INSPECTED:

209 South Fifth Street
Mount Horeb, Wisconsin

INSPECTED FOR:

Sears Mortgage Corporation
2901 West Beltline Highway
Madison, Wisconsin 53713

Attn: Beth

COPY TO:

Preferred Title


CLIENT:

Alan Keach
07-48-21219

CERTIFICATE:

"I, Roland F. Sarko, Registered Land Surveyor in the State of Wisconsin, do hereby certify that I have inspected the above described property and that I have mapped the property according to the official records and that I have mapped the locations of all visible structures, the dimensions of all principal buildings, roadways, apparent easements and visible encroachments, if any. This mortgage inspection has been prepared in accordance with the requirements of the Sears Mortgage Corporation and under an agreement between R.F. Sarko and Associates, Inc. and the Sears Mortgage Corporation which excludes this mortgage inspection from all of the requirements of Section AE 5.01, Wisconsin Administrative Code. Therefore, all of the requirements of Section AE 5.01 have not been complied with. This mortgage inspection is made for the exclusive use of the present owners of the property and also those who purchase, mortgage or guarantee the title thereto within one year from date hereof and as to them we certify the accuracy of said mortgage inspection as shown."

Dated this 1st day of July, 1986.

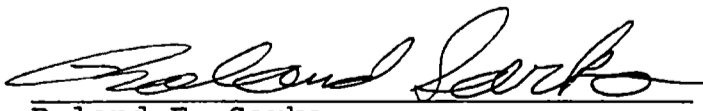

Roland F. Sarko
Wisconsin Registered Land Surveyor
Number S-1377





Map Number: 4-17113
Job Number: 12946
Page Two of Two

MORTGAGE INSPECTION

R.F. Sarko and Associates, Inc.
Land Surveyors
2919 University Avenue
Madison, Wisconsin 53705

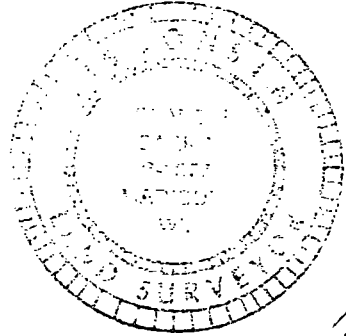

Roland Sarko
7-1-86

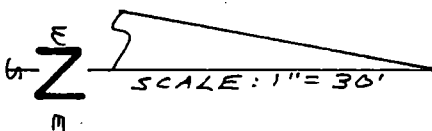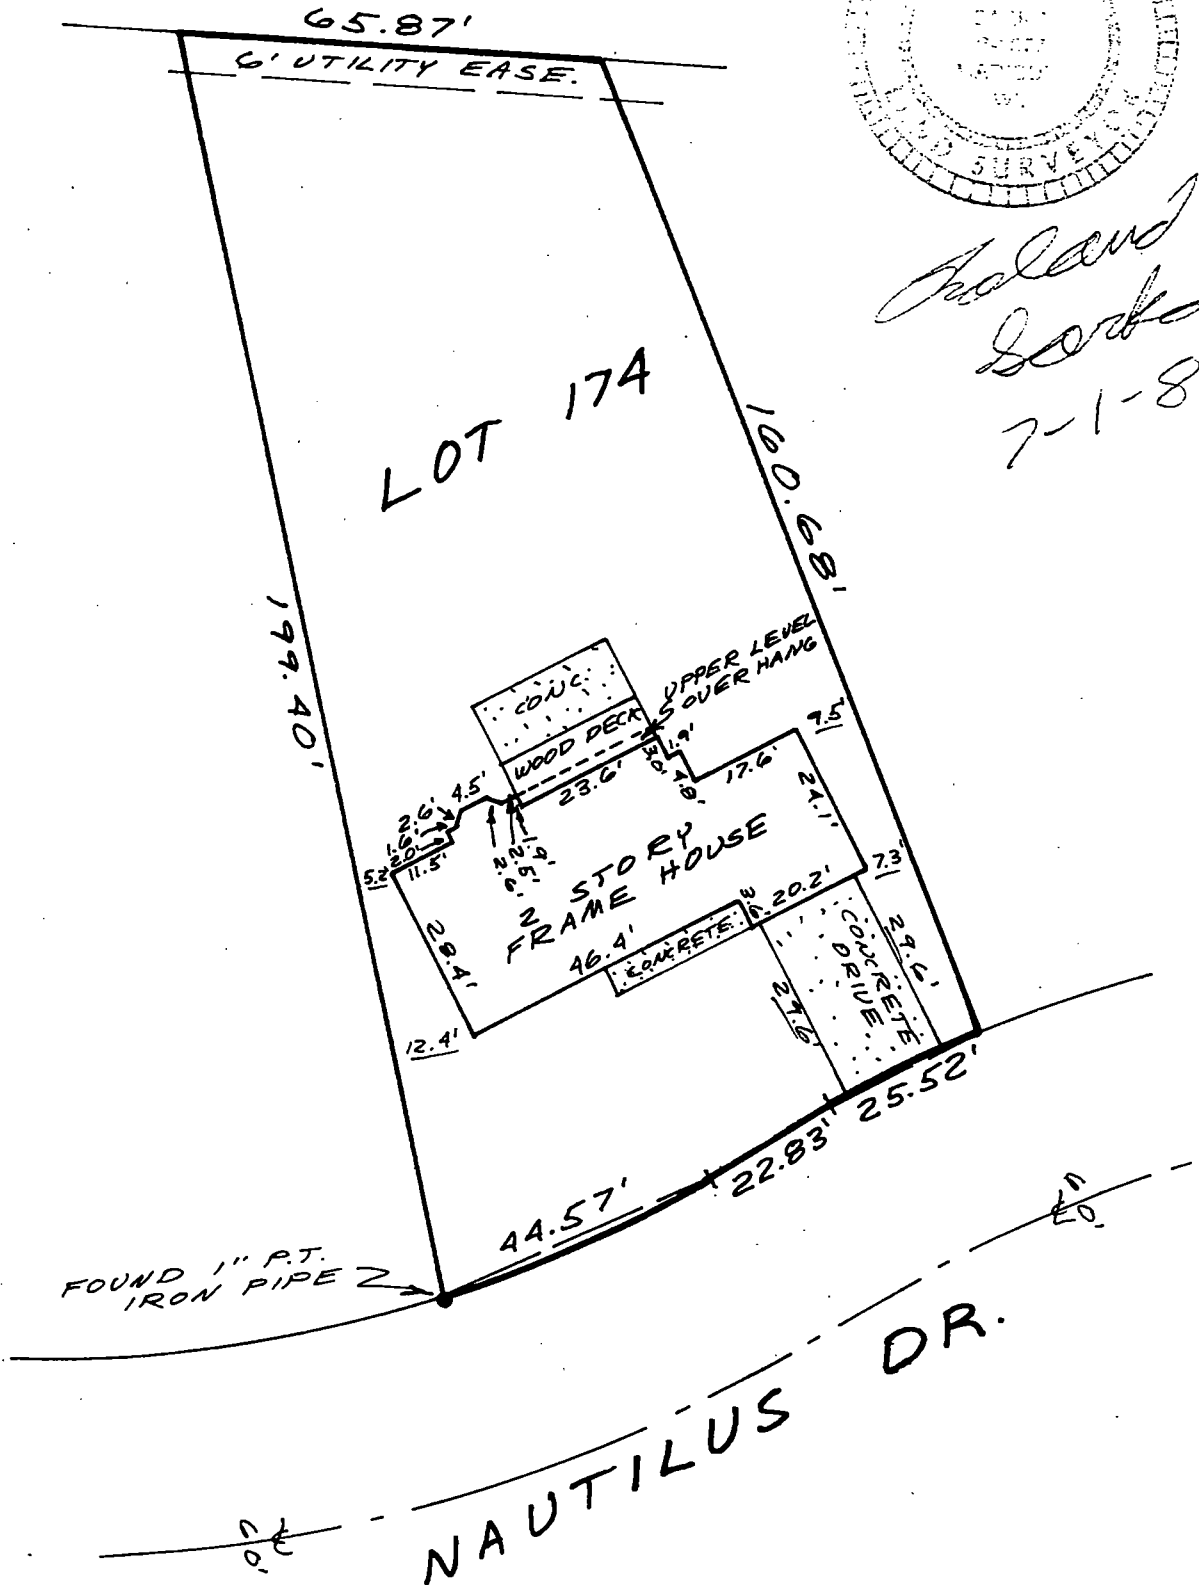

MORTGAGE INSPECTION

R.F. Sarko and Associates, Inc.
Land Surveyors
2919 University Avenue
Madison, Wisconsin 53705

LEGAL DESCRIPTION OF PROPERTY INSPECTED:

Lot 174, Sixth Addition to Faircrest, City of Madison, Dane County, Wisconsin.

ADDRESS OF PROPERTY INSPECTED:

122 Nautilus Drive
Madison, Wisconsin

INSPECTED FOR:

Sears Mortgage Corporation
2901 West Beltline Highway
Madison, Wisconsin 53713

Attn: Beth

COPY TO:

Preferred Title

CLIENT:

Don & Marilyn Crafton
09-48-21472


CERTIFICATE:

"I, Roland F. Sarko, Registered Land Surveyor in the State of Wisconsin, do hereby certify that I have inspected the above described property and that I have mapped the property according to the official records and that I have mapped the locations of all visible structures, the dimensions of all principal buildings, roadways, apparent easements and visible encroachments, if any. This mortgage inspection has been prepared in accordance with the requirements of the Sears Mortgage Corporation and under an agreement between R.F. Sarko and Associates, Inc. and the Sears Mortgage Corporation which excludes this mortgage inspection from all of the requirements of Section AE 5.01, Wisconsin Administrative Code. Therefore, all of the requirements of Section AE 5.01 have not been complied with. This mortgage inspection is made for the exclusive use of the present owners of the property and also those who purchase, mortgage or guarantee the title thereto within one year from date hereof and as to them we certify the accuracy of said mortgage inspection as shown."



Dated this 1st day of July, 1986.



Roland F. Sarko
Wisconsin Registered Land Surveyor
Number S-1377

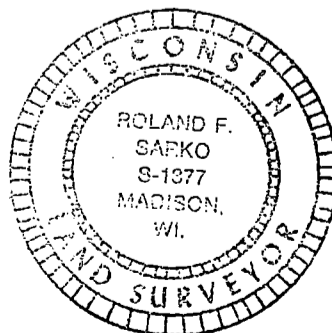

R.F. Sarko and Associates, Inc.
Land Surveyors
2919 University Avenue
Madison, Wisconsin 53705

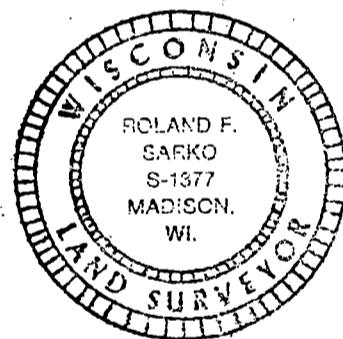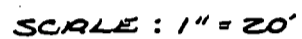

Pauland
Lark
7-1-86

Map Number: 4-17115
Job Number: 12887
Page One of Two

MORTGAGE INSPECTION

R.F. Sarko and Associates, Inc.
Land Surveyors
2919 University Avenue
Madison, Wisconsin 53705

LEGAL DESCRIPTION OF PROPERTY INSPECTED:

Lot 183, Fifth Addition to Village View Heights, City of Sun Prairie, Dane County, Wisconsin.

ADDRESS OF PROPERTY INSPECTED:

470 Robert Drive
Sun Prairie, Wisconsin 53590

INSPECTED FOR:

Sears Mortgage Corporation
2901 West Beltline Highway
Madison, Wisconsin 53713

Attn: Beth

COPY TO:

Badger Abstract


CLIENT:

Terry & Gayle Gittinger
09-48-21456

CERTIFICATE:

"I, Roland F. Sarko, Registered Land Surveyor in the State of Wisconsin, do hereby certify that I have inspected the above described property and that I have mapped the property according to the official records and that I have mapped the locations of all visible structures, the dimensions of all principal buildings, roadways, apparent easements and visible encroachments, if any. This mortgage inspection has been prepared in accordance with the requirements of the Sears Mortgage Corporation and under an agreement between R.F. Sarko and Associates, Inc. and the Sears Mortgage Corporation which excludes this mortgage inspection from all of the requirements of Section AE 5.01, Wisconsin Administrative Code. Therefore, all of the requirements of Section AE 5.01 have not been complied with. This mortgage inspection is made for the exclusive use of the present owners of the property and also those who purchase, mortgage or guarantee the title thereto within one year from date hereof and as to them we certify the accuracy of said mortgage inspection as shown."

Dated this 1st day of July, 1986.


Roland F. Sarko
Wisconsin Registered Land Surveyor
Number S-1377



Map Number: 4-17115
Job Number: 12887
Page Two of Two