DANE COUNTY PUBLIC LAND SURVEY MONUMENT RECORD

This record shall show the location of the corner and shall include all of the following nine elements (a through j).

(a) CORNER LOCATION

MARK CORNER LOCATION

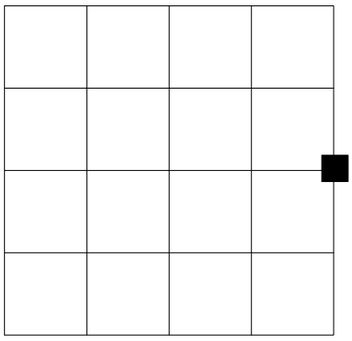

SECTION NUMBER: 3

TOWNSHIP 6 **NORTH, RANGE** 10 **EAST**

DANE COUNTY COORDINATES

NORTHING: 460115.73'

EASTING: 847236.26'

HORIZONTAL DATUM & ADJUSTMENT: NAD 83 (2011)

ORTHOMETRIC HEIGHT: 869.10' **VERTICAL DATUM:** NAVD 88

(b) Describe any record evidence, monument evidence, occupational evidence, testimonial evidence or any other material evidence you considered, and whether the monument was found or placed.

I found a 3/4" solid round iron rod with a plastic cap of unknown origin matching tie distances. Plastic cap was consistent with caps set by Carl Sandsnes.

(c) CORNER LOCATION SKETCH: In the sketch, provide reference ties to at least 4 witness monuments of lasting durable material.

(d) The sketch shall include physical features surrounding the monument location sufficient to easily find the monument when in the general area, such as but not limited to utility poles, signs, trees, edges of forests or cropland, field lanes, water bodies, pavement, buildings, etc. Sketch shall also indicate north and scale, and include descriptions of symbols, in sketch or by legend.

Bearings are grid based on the Dane County coordinate system designed by the Wisconsin Department of Transportation. NAD83 (2011)

Scale: 1" = 40'

- ○ **Denotes found 3/4" solid round iron rod.**
- ● **Denotes found 3/4" solid round iron rod with plastic cap.**

Recorded distances are shown in parentheses.

I found a 3/4" solid round iron rod with a plastic cap at the corner.

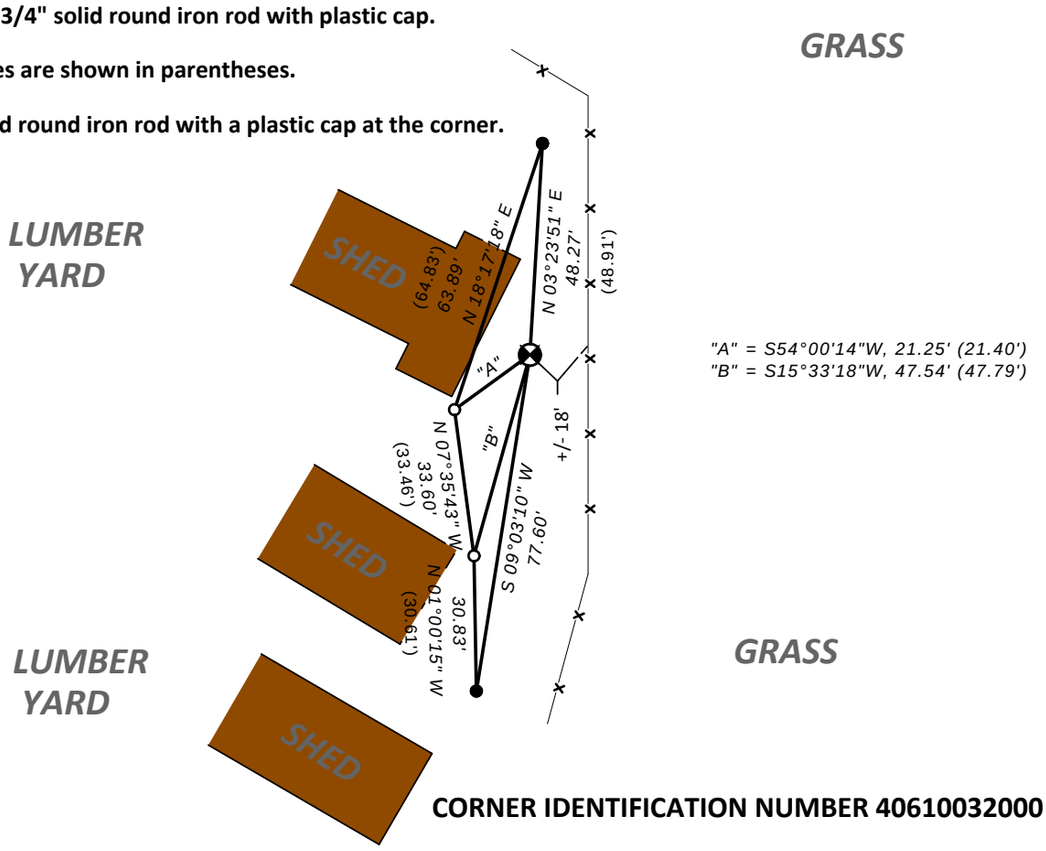

CORNER IDENTIFICATION NUMBER 40610032000

(e) Describe any material discrepancy between the location of the corner as restored or reestablished and the location of that corner as previously restored or reestablished by distance and direction. Show the discrepancy in the sketch on sheet 1.

None

(f) Was the corner restored through acceptance of (1) an obliterated evidence location, or (2) a found perpetuated location?

(2) a found perpetuated location

(g&h) Was the corner reestablished through proportionate methods? If so, show the method, including the directions and distances to other public land survey corners used as evidence or used for proportioning in determining the corner location.

No

(i) List all previous Monument Records found, previously filed for the subject corner, including monument types set or found, surveyor, and date of survey.

- On April 20, 1857, A. Sigowski was at this corner while working in Section 2.
Bluebook Surveys volume 2, page 169.
-On July 24th, 1857, William M. Hough was at this corner while subdividing Section 3.
Bluebook Surveys volume 2, page 53.
- On November 28, 1866, J.D. Coryell was at this corner while subdividing Section 2.
Bluebook Surveys volume 5, page 220.
- In June, 1978, William Karns set an aluminum monument.
Monument Reference Sheet.
- In May, 1993, Carl Sandsnes found the aluminum monument set by Karns.
Monument Reference Sheet.

(j) I, Richard Marks, Professional Land Surveyor number S-1473 hereby certify that the corner location shown on this record was determined by me or under my direction and is correct. This U.S. Public Land Survey Monument Record is complete to the best of my knowledge and belief.

9/28/2014

Richard Marks Date
Professional Land Surveyor number S-1473

Affix Land Surveyor seal

WISCONSIN
RICHARD W. MARKS S-1473 SAUK CITY, WIS.
LAND SURVEYOR

CORNER IDENTIFICATION NUMBER 40610032000