DANE COUNTY PUBLIC LAND SURVEY MONUMENT RECORD

This record shall show the location of the corner and shall include all of the following nine elements (a through j).

(a) CORNER LOCATION

MARK CORNER LOCATION

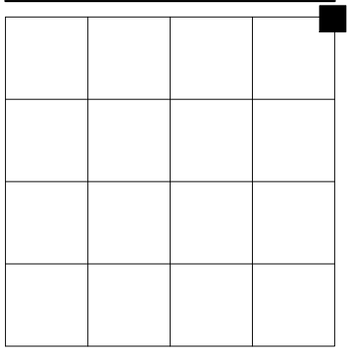

SECTION NUMBER: 6

TOWNSHIP 6 NORTH, RANGE 10 EAST

DANE COUNTY COORDINATES

NORTHING: 462242.70'

EASTING: 831697.43'

HORIZONTAL DATUM & ADJUSTMENT: NAD 83 (2011)

ORTHOMETRIC HEIGHT: 870.60' VERTICAL DATUM: NAVD 88

(b) Describe any record evidence, monument evidence, occupational evidence, testimonial evidence or any other material evidence you considered, and whether the monument was found or placed.

I found a concrete monument with a brass cap per Monument Record Sheets by Bruce Frudden and Michelle Burse.

(c) CORNER LOCATION SKETCH: In the sketch, provide reference ties to at least 4 witness monuments of lasting durable material.

(d) The sketch shall include physical features surrounding the monument location sufficient to easily find the monument when in the general area, such as but not limited to utility poles, signs, trees, edges of forests or cropland, field lanes, water bodies, pavement, buildings, etc. Sketch shall also indicate north and scale, and include descriptions of symbols, in sketch or by legend.

Bearings are grid based on the Dane County coordinate system designed by the Wisconsin Department of Transportation. NAD83 (2011)

Scale: 1" = 40'

○ Denotes set 3/4" x 24" solid round iron rod.

I found a concrete monument with a brass cap at the corner.

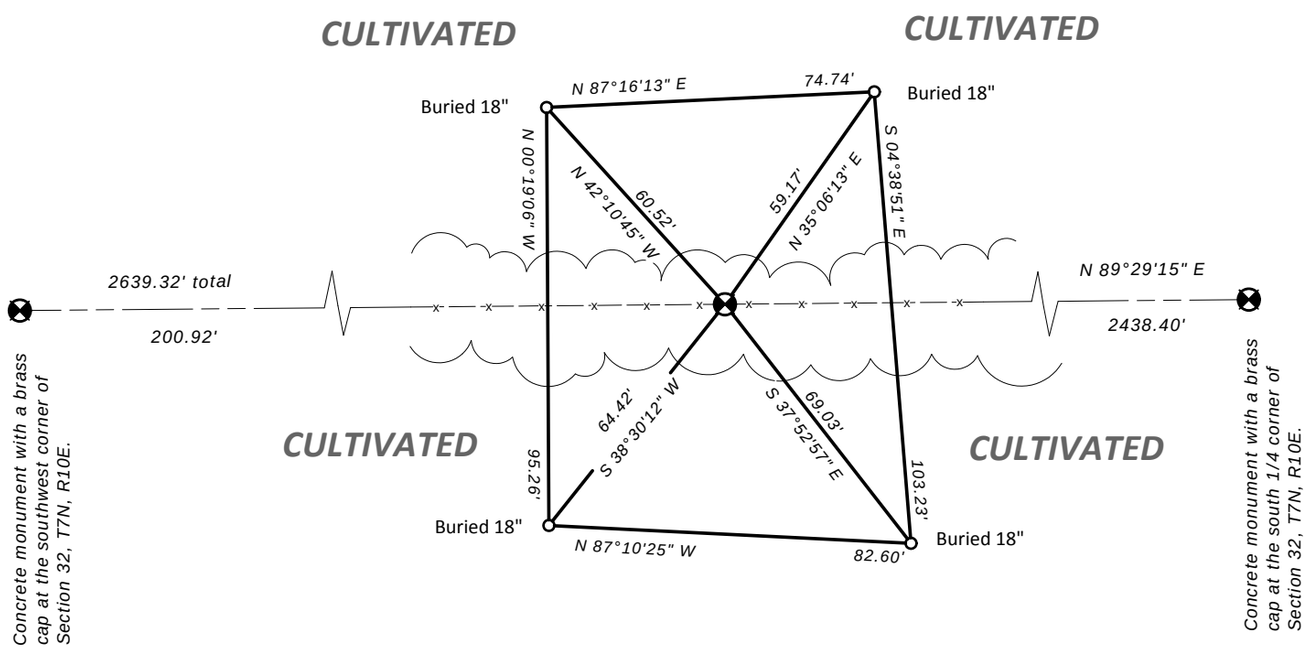

CORNER IDENTIFICATION NUMBER 40610064000

(e) Describe any material discrepancy between the location of the corner as restored or reestablished and the location of that corner as previously restored or reestablished by distance and direction. Show the discrepancy in the sketch on sheet 1.

None

(f) Was the corner restored through acceptance of (1) an obliterated evidence location, or (2) a found perpetuated location?

(2) a found perpetuated location

(g&h) Was the corner reestablished through proportionate methods? If so, show the method, including the directions and distances to other public land survey corners used as evidence or used for proportioning in determining the corner location.

No

(i) List all previous Monument Records found, previously filed for the subject corner, including monument types set or found, surveyor, and date of survey.

- Original surveyor intersected the south line of T7N, R10E, 201.30' east of the southeast corner of Section 31, T7N, R10E.
- On April 10, 1872, L.P. Drake was at this corner while working in Section 5.
Bluebook Surveys volume 5, page 226.
- On October 18, 1893, W.L. Marcy was at this corner while measuring the west line of Section 5 and notes a 100 foot shortage in the U. S. measurement along the west line of Section 5.
Bluebook Surveys volume 5, page 226.
On August 1, 1914, P.H. Hintze was at this corner while working in Section 6.
Bluebook Surveys volume 1, page 181.
- On May 6, 1965, Bruce O. Frudden set a concrete monument with a brass cap on the south line of the SE1/4 of Section 32 and 200.6 feet east of the south 1/4 corner of Section 32.
Monument Record Sheet.
- On May 12, 1997, Michelle Burse found a concrete monument with a brass cap missing marking the corner as set by Mead & Hunt in 1968. Monument Record Sheet.

(j) I, Richard Marks, Professional Land Surveyor number S-1473 hereby certify that the corner location shown on this record was determined by me or under my direction and is correct. This U.S. Public Land Survey Monument Record is complete to the best of my knowledge and belief.

9/28/2014

Richard Marks Date
Professional Land Surveyor number S-1473

Affix Land Surveyor seal

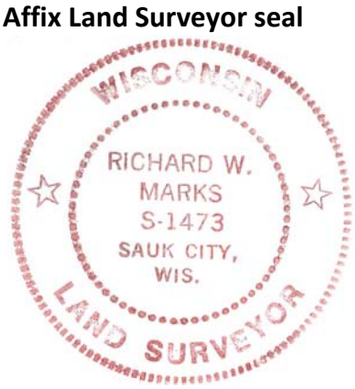

CORNER IDENTIFICATION NUMBER 40610064000